

MISSISSIPPI DEPARTMENT OF NATURAL RESOURCES

Bureau of Land and Water Resources

Southport Mall

P.O. Box 10631

Jackson, Mississippi 39209

WATER WELL DRILLERS LOG

F 2034  
 HARRISON  
 8-10-85

8-10-85 19  
 date well completed

R.T. Moore  
 firm name

HARRISON  
 county well located

LANDOWNER: ROBERT C STARR  
John Clarke RD  
Centerville MS  
 (mailing address)  
 WELL LOCATION:  
 sec. 36 T. 6 N. R. 12 E  
 (S) (W)  
3 miles W of Meridian  
 (distance) (direction) (nearest town)

description of formations encountered	from	to
TOPSOIL	0	10
White + Blue Clay	10	80
Blue Clay	80	200
Red Sand	200	270
Blue Clay	270	500
Red Sand	500	560

WELL PURPOSE:  
 (home, irrigation, municipal, industrial)

WELL COMPLETION DATA:  
 (1) diameter (inches) 2"  
 (2) total depth (feet) 560'  
 (3) static water level (feet) 100' below above top of ground.  
 (4) casing PCP, 560,  
 (material) (depth)  
 (size) if telescope see back.  
 (5) screen 10', 560'  
 (length) (depth to top)  
2", PCP  
 (size) (material)  
 (6) pump 1 1/2 5  
 (HP) (yield gpm)  
E  
 (type power)  
 (7) electric log yes or no  
 (organization running log)  
 (8) how well bottom plugged Good


DRILLERS REMARKS:

RECEIVED  
 OCT 10 1985

Department of Natural Resources  
 Bureau of Land & Water Resources

If well telescopes please sketch and show depths.

GROUND LEVEL

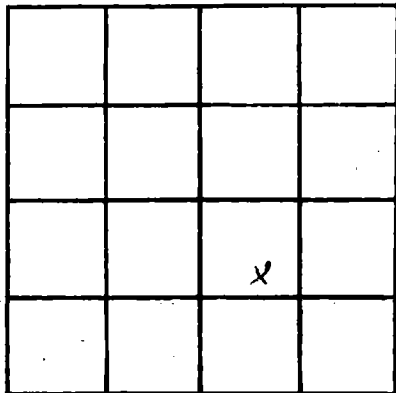

SECTION 36

Please indicate well location X.

ADDITIONAL INFORMATION

If more than one screen, show locations of each on sketch.