

MISSISSIPPI DEPARTMENT OF NATURAL RESOURCES

Bureau of Land and Water Resources

Southport Mall

P.O. Box 10631

Jackson, Mississippi 39209

WATER WELL DRILLERS LOG

HARRISON
F2037

11-19-85 19 Mc Mill Pump & Wells Harrison
date well completed firm name county well located

LANDOWNER: Pat Whittington
Echo Hills
Shuffport, Mo. 39503
(mailing address)

WELL LOCATION:
sec 35 T. 65 N R. 12 W
S W
8 miles N/W of Shuffport
(distance) (direction) (nearest town)

WELL PURPOSE: Home
(home, irrigation, municipal, industrial)

WELL COMPLETION DATA:

- (1) diameter (inches) 2"
- (2) total depth (feet) 250'
- (3) static water level (feet) 30 ^{below} top of ground
- (4) casing pcv 240'
(material) (depth)
- If telescope see back.
(size)
- (5) screen 10' 240
(length) (depth to top)
- 2" sch 80 16 slot
(size) (material)
- (6) pump 1 10
(HP) (yield gpm)
- 0 Dec
(type power)
- (7) electric log
(yes or no)
- (organization running log)
- (8) how well bottom plugged Seal

description of formations encountered	from	to
Hard sand	0-	10
S mud	10-	150
Mud/sand	150	160
Sand/mud	160-	180
Mud	180	290
Sand	290	300
Mud	300	470
Sand	470	520

RECEIVED


DEC 13 1985

Department of Natural Resources
Bureau of Land & Water Resources

DRILLERS REMARKS:

If well telescopes please sketch and show depths.

GROUND LEVEL

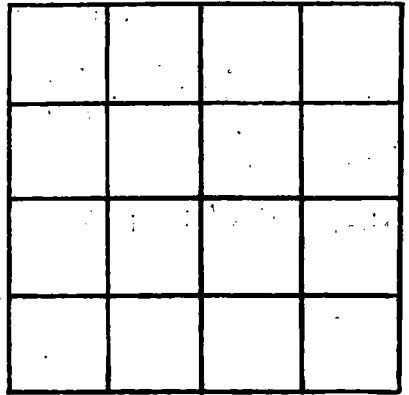

SECTION _____

Please indicate well location X.

ADDITIONAL INFORMATION

If more than one screen,
show locations of each on sketch.