

MISSISSIPPI DEPARTMENT OF NATURAL RESOURCES
Bureau of Land and Water Resources
 Southport Mall
 P.O. Box 10631
 Jackson, Mississippi 39209
WATER WELL DRILLERS LOG

HARRISON
F 2038

10-19-85
 date well completed

J. Meeker Well Drilling
 firm name

HARRISON
 county well located

LANDOWNER: TROY BORN

description of formations encountered

from to

Hwy 53

LIZIANA MS 39503
 (mailing address)

<u>TOP SOIL</u>	<u>0</u>	<u>12</u>
<u>RED SAND</u>	<u>12</u>	<u>20</u>
<u>WHITE CLAY</u>	<u>20</u>	<u>80</u>
<u>Blue Clay</u>	<u>80</u>	<u>200</u>
<u>Orange white sand</u>	<u>200</u>	<u>220</u>

WELL LOCATION:

sec. 18T 6N R. 12E
1/4 miles E of LIZIANA CHURCH
 (distance) (direction) (nearest town)

WELL PURPOSE:

(Home, Irrigation, municipal, Industrial)

WELL COMPLETION DATA:

- (1) diameter (inches) 2"
- (2) total depth (feet) 220'
- (3) static water level (feet) 55' ^{below} top of ground
- (4) casing PVC, 220'
 (material) (depth)

 (size) If telescope see back.

- (5) screen 2" x 10', 220'
 (length) (depth to top)

 , PVC
 (size) (material)

- (6) pump 1 8
 (HP) (yield gpm)

E
 (type power)

- (7) electric log
 (yes or no)

 (organization running log)

- (8) how well bottom plugged

DRILLERS REMARKS:


RECEIVED

JAN 02 1986

Department of Natural Resources
 Bureau of Land & Water Resources

If well telescopes please sketch and show depths.

GROUND LEVEL

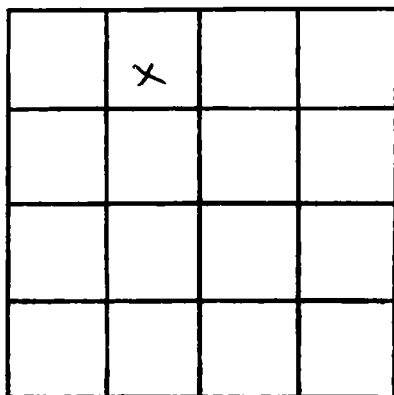

SECTION 18

Please indicate well location X.

ADDITIONAL INFORMATION

If more than one screen, show locations of each on sketch.