

MISSISSIPPI DEPARTMENT OF NATURAL RESOURCES

Bureau of Land and Water Resources

Southport Mall

P.O. Box 10631

Jackson, Mississippi 39209

WATER WELL DRILLERS LOG

HARRISON
F2039

11-7-85
date well completed

R. J. Moore Well Drilling
firm name

Harrison
county well located

LANDOWNER: C. M. Cablenitz

SOUTH B19 HILL RD

21214th MS 39583

(mailing address)

WELL LOCATION:

sec. 29 T. 6 N. R. 12 E. W
3 miles SE of LIZIANKA
(distance) (direction) (nearest town)

WELL PURPOSE:

(home, irrigation, municipal, industrial)

WELL COMPLETION DATA:

- (1) diameter (inches) 2"
- (2) total depth (feet) 600'
- (3) static water level (feet) 70' (below/above top of ground)
- (4) casing PVC, 600
(material) (depth)

(size) if telescope see back.

- (5) screen 2" x 10', 600
(length) (depth to top)

(size) (material)

- (6) pump 1 1/2 (HP) 10 (yield gpm)

E
(type power)

- (7) electric log (yes or no)


(organization running log)

- (8) how well bottom plugged By the

description of formations encountered

from to

<u>TOP SOIL</u>	<u>0</u>	<u>20</u>
<u>Blue Clay</u>	<u>20</u>	<u>540'</u>
<u>Green Grassy Sand</u>	<u>540</u>	<u>600</u>

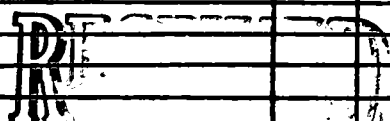

JAN 9 1986

Department of Natural Resources
Bureau of Land & Water Resources

DRILLERS REMARKS:

If well telescopes please sketch and show depths.

GROUND LEVEL

			X

SECTION 29

Please indicate well location X.

ADDITIONAL INFORMATION

If more than one screen, show locations of each on sketch.