

MISSISSIPPI DEPARTMENT OF NATURAL RESOURCES

Bureau of Land and Water Resources

Southport Mall

P.O. Box 10631

Jackson, Mississippi 39209

WATER WELL DRILLERS LOG

HARRISON
F 2040

11-30-85 19
date well completed

R. Smoke
firm name

HARRISON
county well located

LANDOWNER: ROZANN FORD
TWIN LAKES
WEST LAKE RD LOT 56 + 57
SHAW RD
Stucle MS
(mailing address)

description of formations encountered	from	to
TOP SOIL	0	20
White Clay	20	160
FINE Sand	160	180
Blue Clay	180	600
Med Sand	600	625

WELL LOCATION:


sec. 3 T. 6 N. R. 12 E
4 miles W of WORTHMAN
(distance) (direction) (nearest town)

WELL PURPOSE:

(home, irrigation, municipal, industrial)

WELL COMPLETION DATA:

- (1) diameter (inches) 2"
- (2) total depth (feet) 625"
- (3) static water level (feet) 52' ^{below} _{above} top of ground.
- (4) casing Pvc, 625'
(material) (depth)
(size) If telescope see back.
- (5) screen 2" x 10', 625'
(length) (depth to top)
2", Pvc
(size) (material)
- (6) pump _____
(HP) (yield gpm)
(type power)
- (7) electric log _____
(yes or no)
(organization running log)
- (8) how well bottom plugged By
them

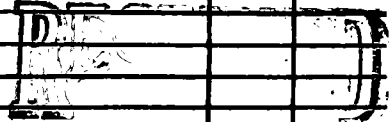


JAN 6 1986

Department of Natural Resources
Bureau of Land & Water Resources

DRILLERS REMARKS:

If well telescopes please sketch and show depths.

GROUND LEVEL

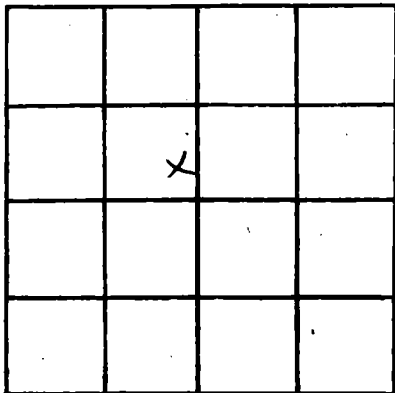

SECTION 3

Please indicate well location X.

ADDITIONAL INFORMATION

If more than one screen, show locations of each on sketch.