

MISSISSIPPI DEPARTMENT OF NATURAL RESOURCES

Bureau of Land and Water Resources

Southport Mall

P.O. Box 10631

Jackson, Mississippi 39209

WATER WELL DRILLERS LOG

Harrison  
F 2043

3-5 1986  
date well completed

Mc Hill Pump & Well Harrison  
firm name

county well located

LANDOWNER: Wade Phillips

12704 Carbon Place

D.D. YMS  
(mailing address)

WELL LOCATION: Kongrudge Rd.

sec 35 T 6 N R 12 E

4 miles West of Jefferson  
(distance) (direction) (nearest town)

WELL PURPOSE:

(Home) irrigation, municipal, industrial

WELL COMPLETION DATA:

- (1) diameter (inches) 2"
- (2) total depth (feet) 400'
- (3) static water level (feet) 32' below above top of ground.
- (4) casing 2" sch. 40 390'  
(material) (depth)

       if telescope see back.  
(size)

- (5) screen 10'         
(length) (depth to top)
- 2" sch 80  
(size) (material)

- (6) pump                
(type power)

- (7) electric log         
(yes or no)

        
(organization running log)

- (8) how well bottom plugged sand seal

DRILLERS REMARKS:


description of formations encountered	from	to
<u>mud &amp; sand</u>	<u>0</u>	<u>100</u>
<u>sand</u>	<u>100</u>	<u>180</u>
<u>Blue Clay - sand</u>	<u>180</u>	<u>250</u>
<u>mud</u>	<u>250</u>	<u>300</u>
<u>mud sand</u>	<u>300</u>	<u>350</u>
<u>S. Sand - mud</u>	<u>350</u>	<u>385</u>
<u>coarse sand</u>	<u>385</u>	<u>400</u>

**RECEIVED**  
MAR 28 1986

Department of Natural Resources  
Bureau of Land & Water Resources

If well telescopes please sketch and show depths.

GROUND LEVEL

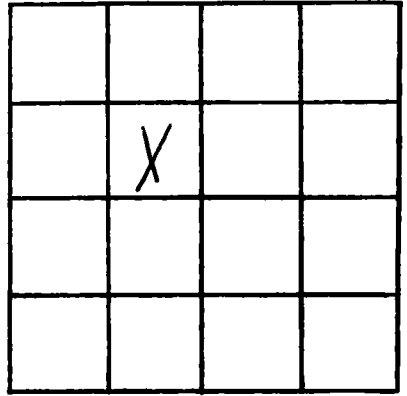

SECTION \_\_\_\_\_

Please indicate well location X.

ADDITIONAL INFORMATION

If more than one screen, show locations of each on sketch.