

MISSISSIPPI DEPARTMENT OF NATURAL RESOURCES

Bureau of Land and Water Resources

Southport Mall

P.O. Box 10631

Jackson, Mississippi 39209

WATER WELL DRILLERS LOG

Harrison
P 2014

3/15/85
 date well completed

Lyman
 firm name

Harrison
 county well located

LANDOWNER:

Robinson, Sandra
Rt. 3, Box 618
Southport, Md 39503
 (mailing address)

Description of formations encountered

from

to

SAND & gravel
white clay
SAND

0 50
50 200
200 225

WELL LOCATION:

sec 22 T 6 N R 22 E
3 miles west of Wright
 (distance) (direction) (nearest town)

WELL PURPOSE:

Home
 (home, irrigation, municipal, industrial)

WELL COMPLETION DATA:

- (1) diameter (inches) 2"
- (2) total depth (feet) ~~210~~ 210
- (3) static water level (feet) 66' ^{below} _{above} top of ground.
- (4) casing P.V.C. 200'
 (material) (depth)
2"
 (size) if telescope see back.
- (5) screen 10" 210'
 (length) (depth to top)
2 PVC
 (size) (material)
- (6) pump N.A.
 (HP) (yield gpm)
 (type power)
- (7) electric log no
 (yes or no)
no
 (organization running log)
- (8) how well bottom plugged SAND
SHARK

RECEIVED


APR 9 1985

DRILLERS REMARKS:

Department of Natural Resources
 Bureau of Land & Water Resources

If well telescopes please sketch and show depths.

GROUND LEVEL

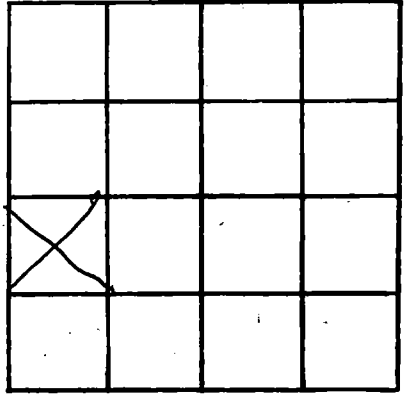

SECTION 82

Please indicate well location X.

ADDITIONAL INFORMATION

Multiple horizontal lines for writing additional information.

If more than one screen, show locations of each on sketch.