

MISSISSIPPI DEPARTMENT OF NATURAL RESOURCES

Bureau of Land and Water Resources

Southport Mall

P.O. Box 10631

Jackson, Mississippi 39209

WATER WELL DRILLERS LOG

HARRISON
F 2046

6/18/85 19
date well completed

Homer Lyman Well
firm name

Harrison
county well located

LANDOWNER

Homer Dedeaux

Description of formations encountered

from to

4512 Harrison Ave
Gulfport, Md 39501
(mailing address)

white clay 0 40
Blue clay 40 620
sand coarse 620 656

WELL LOCATION:

sec 23 T 6 N R 12 E
S W
5 miles south of Gulfport
(distance) (direction) (nearest town)

WELL PURPOSE:

home
(home, irrigation, municipal, industrial)

WELL COMPLETION DATA:

- (1) diameter (inches) 2"
- (2) total depth (feet) 656'
- (3) static water level (feet) 110' ^{below} above top of ground.
- (4) casing PVC 646'
(material) (depth)
2" If telescope see back.
(size)
- (5) screen 10' 646'
(length) (depth to top)
2" PVC
(size) (material)
- (6) pump 1/2 6
(HP) (yield gpm)
electric
(type power)
- (7) electric log No
(yes or no)
No
(organization running log)
- (8) how well bottom plugged sand
shark


RECEIVED
APR - 9 1986

DRILLERS REMARKS:

Department of Natural Resources
Bureau of Land & Water Resources

If well telescopes please sketch and show depths.

GROUND LEVEL

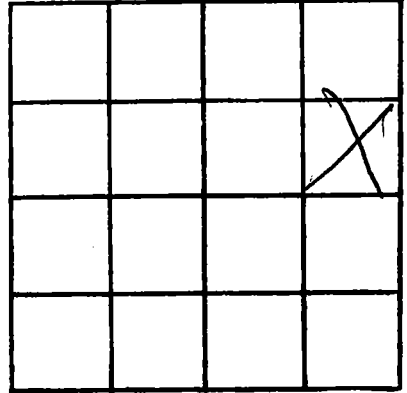

SECTION 23

Please indicate well location X.

ADDITIONAL INFORMATION

If more than one screen, show locations of each on sketch.