

MISSISSIPPI DEPARTMENT OF NATURAL RESOURCES

Bureau of Land and Water Resources

Southport Mall

P.O. Box 10631

Jackson, Mississippi 39209

WATER WELL DRILLERS LOG

HARRISON
F 247

7/3/85
date well completed

19 Lyman Well Co.
firm name

Harrison
county well located

LANDOWNER:

Susan Sims

description of formations encountered

from

to

Echo Hills

Gulfport Ms 39503
(mailing address)

Top soil

0

4

yellow

4

12

mixed white

12

25

small red

25

48

yellow clay

48

90

red yellow

90

130

blue clay

130

360

sand

360

400

blue clay

400

480

sand - medium

480

520

WELL LOCATION:

sec. 30 T. 6 N. R. 12 E.
7 miles W of Gulfport
(distance) (direction) (nearest town)

WELL PURPOSE:

(home, irrigation, municipal, industrial)

WELL COMPLETION DATA:

- (1) diameter (inches) 2"
- (2) total depth (feet) 516'
- (3) static water level (feet) 79' below above top of ground.
- (4) casing PVC 506'
(material) (depth)
- 2"
(size) if telescope see back.
- (5) screen 10' 506'
(length) (depth to top)
- 2" PVC
(size) (material)
- (6) pump 1 1/2 11
(HP) (yield gpm)
- electric
(type power)
- (7) electric log No
(yes or no)
- NO
(organization running log)
- (8) how well bottom plugged sand
shark


RECEIVED
APR - 9 1986

DRILLERS REMARKS:

Department of Natural Resources
Bureau of Land & Water Resources

If well telescopes please sketch and show depths.

GROUND LEVEL

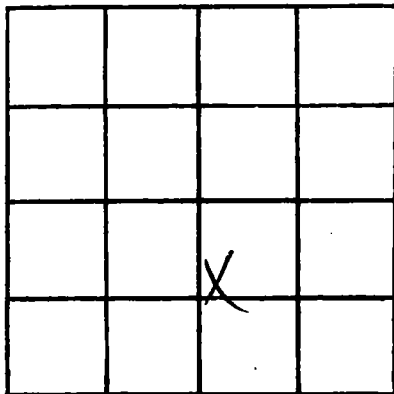

SECTION 35

Please indicate well location X.

ADDITIONAL INFORMATION

If more than one screen, show locations of each on sketch.