

MISSISSIPPI DEPARTMENT OF NATURAL RESOURCES

Bureau of Land and Water Resources

Southport Mall

P.O. Box 10631

Jackson, Mississippi 39209

WATER WELL DRILLERS LOG

HARRISON  
F 2018

9/30/85, 19 Lyman Well Co. Harrison  
date well completed firm name county well located

LANDOWNER: Landra Robinson  
Rt. 3, Box 1018  
Georgetown 39503  
(mailing address)

Description of formations encountered	from	to
Top soil	0	2
yellow clay	2	10
marl clay	10	50
blue clay	50	80
yellow clay	80	120
yellow sand	120	210

WELL LOCATION:  
sec. 23 T. 6 N. R. 12 E. W/4  
6 miles N of Geot  
(distance) (direction) (nearest town)

WELL PURPOSE: Home  
(home, irrigation, municipal, industrial)

WELL COMPLETION DATA:

- (1) diameter (inches) 2"
- (2) total depth (feet) 210'
- (3) static water level (feet) 66' below above top of ground.
- (4) casing PVC, 200'  
(material) (depth)  
2" If telescope see back.  
(size)
- (5) screen 10', 200'  
(length) (depth to top)  
2" PVC  
(size) (material)
- (6) pump 1 8  
(HP) (yield gpm)  
electric  
(type power)
- (7) electric log NO  
(yes or no)  
NO  
(organization running log)
- (8) how well bottom plugged sand  
shack


DRILLERS REMARKS:

**RECEIVED**  
APR - 9 1986

Department of Natural Resources  
Bureau of Land & Water

If well telescopes please sketch and show depths.

GROUND LEVEL

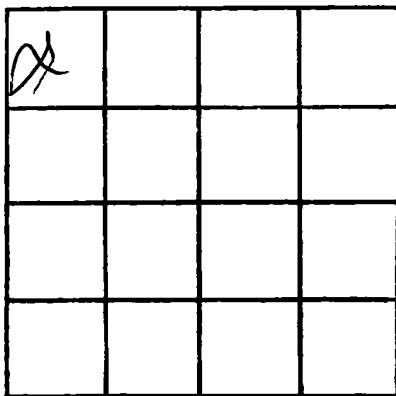

SECTION 23

Please indicate well location X.

ADDITIONAL INFORMATION

If more than one screen, show locations of each on sketch.