

HARRISON
F 2049

MISSISSIPPI DEPARTMENT OF NATURAL RESOURCES
Bureau of Land and Water Resources
Southport Mall
P.O. Box 10631
Jackson, Mississippi 39209
WATER WELL DRILLERS LOG

12/11/85 19 Syman Well Co Harrison
date well completed firm name county well located

LANDOWNER: George Lofton
Rt. 5, Box 108
Southport, MS 39503
(mailing address)

description of formations encountered	from	to
<u>evg sand</u>	<u>0</u>	<u>3</u>
<u>shaly yellow clay</u>	<u>3</u>	<u>15</u>
<u>light clay</u>	<u>15</u>	<u>45</u>
<u>blue clay</u>	<u>45</u>	<u>150</u>
<u>sand</u>	<u>150</u>	<u>225</u>

WELL LOCATION:
sec 3 T 6 N R. 12 E
12 miles W of Lyfkes
(distance) (direction) of (nearest town)

WELL PURPOSE: Home
(home, irrigation, municipal, industrial)

WELL COMPLETION DATA:

(1) diameter (inches) 4"

(2) total depth (feet) 225'

(3) static water level (feet) 4' below top of ground. above

(4) casing PVC, 215'
(material) (depth)
4" If telescope see back.
(size)

(5) screen 10', 215'
(length) (depth to top)
4" (size) PVC (material)

(6) pump 1 (HP) 30 (yield gpm)
electric (type power)

(7) electric log NO (yes or no)
NO (organization running log)

(8) how well bottom plugged sand
shark


RECEIVED
APR - 9 1986

DRILLERS REMARKS:

Department of Natural Resources
Bureau of Land & Water

If well telescopes please sketch and show depths.

GROUND LEVEL

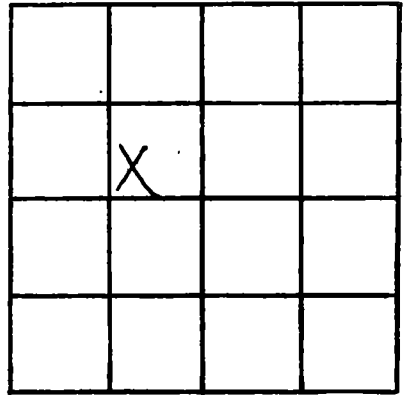

SECTION 3

Please indicate well location X.

ADDITIONAL INFORMATION

If more than one screen, show locations of each on sketch.