

MISSISSIPPI DEPARTMENT OF NATURAL RESOURCES
Bureau of Land and Water Resources
 Southport Mall
 P.O. Box 10631
 Jackson, Mississippi 39209
WATER WELL DRILLERS LOG

Harrison
F 2050

2/4/86 19 Lyman Well Co. Harrison
 date well completed firm name county well located

LANDOWNER	description of formations encountered	from	to
<u>Liberty House of Prayer</u>	<u>Topsoil</u>		<u>1'</u>
	<u>Clay</u>	<u>1'</u>	<u>12'</u>
	<u>Sand</u>	<u>17'</u>	<u>152'</u>

WELL LOCATION:
 sec. 24 T. 6 N R. 12 E
 (distance) (direction) of Southport
 (nearest town)

WELL PURPOSE: Church
 (home, irrigation, municipal, industrial)

- WELL COMPLETION DATA:**
- (1) diameter (inches) 4"
 - (2) total depth (feet) 152'
 - (3) static water level (feet) 50' ^{below} above top of ground.
 - (4) casing PVC 142'
 (material) (depth)
4"
 (size) If telescope see back.
 - (5) screen 10' 142'
 (length) (depth to top)
4" PVC
 (size) (material)
 - (6) pump 1 2.5
 (HP) (yield gpm)
electric
 (type power)
 - (7) electric log No
 (yes or no)
No
 (organization running log)
 - (8) how well bottom plugged sand
shark

RECEIVED


OCT 06 1986

Department of Natural Resources
 Bureau of Land & Water Resources

DRILLERS REMARKS:

If well telescopes please sketch and show depths.

GROUND LEVEL

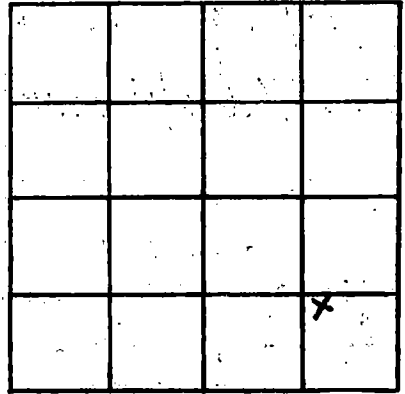

SECTION 24

Please indicate well location X.

ADDITIONAL INFORMATION

If more than one screen, show locations of each on sketch.