

MISSISSIPPI DEPARTMENT OF NATURAL RESOURCES

Bureau of Land and Water Resources

Southport Mall

P.O. Box 10631

Jackson, Mississippi 39209

WATER WELL DRILLERS LOG

HARRISON  
F2051

3-17-86

date well completed

R Moore

firm name

HARRISON

county well located

LANDOWNER: BARRY HANDLEY  
LIZIWA SCHOOL RD  
LIZIWA

description of formations encountered

from

to

Outpost ms  
(mailing address)

<u>Red clay</u>	<u>0</u>	<u>20</u>
<u>Co. G. clay</u>	<u>20</u>	<u>60</u>
<u>Blue clay</u>	<u>60</u>	<u>240</u>
<u>med sand</u>	<u>240</u>	<u>260</u>

WELL LOCATION:


sec 18 T 6 N R 12 E  
1/4 miles N of LIZIWA School  
(distance) (direction) (nearest town)

WELL PURPOSE:

(home) irrigation, municipal, industrial

WELL COMPLETION DATA:

- (1) diameter (inches) 2"
- (2) total depth (feet) 260'
- (3) static water level (feet) 25' <sup>below</sup> above top of ground.
- (4) casing Pvc, 260'  
(material) (depth)  
(size) if telescope see back.
- (5) screen 10', 260'  
(length) (depth to top)  
2", Pvc  
(size) (material)
- (6) pump 1, 6  
(HP) (yield gpm)  
E  
(type power)
- (7) electric log (yes or no)  
(organization running log)
- (8) how well bottom plugged None

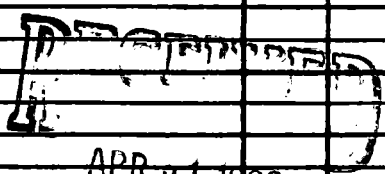

APR 21 1986

Department of Natural Resources  
Bureau of Land & Water Resources

DRILLERS REMARKS:

If well telescopes please  
sketch and show depths.

GROUND LEVEL

X			

SECTION 18

Please indicate well location X.

ADDITIONAL INFORMATION

If more than one screen,  
show locations of each on sketch.