

MISSISSIPPI DEPARTMENT OF NATURAL RESOURCES

Bureau of Land and Water Resources

Southport Mall

P.O. Box 10631

Jackson, Mississippi 39209

WATER WELL DRILLERS LOG

HARRISON
F
2053

4-23-86 19
date well completed

R. J. Moore
firm name

HARRISON
county well located

LANDOWNER: Richard C. Moore

description of formations encountered

from to

John Chance RD

Centerville, MS 39503
(mailing address)

TOP SOIL	0	20
White sand clay	20	40
Red Sand	40	120
Blue Clay	120	420
Med Sand	420	500
Orange Sand	500	540

WELL LOCATION:

sec. 36 T. 6 N. R. 12 E.
3 miles W of NUSENT
(distance) (direction) (nearest town)

WELL PURPOSE:

(home, irrigation, municipal, industrial)

WELL COMPLETION DATA:

(1) diameter (inches) 4 x 2

(2) total depth (feet) 540

(3) static water level (feet) 20' below top of ground.

(4) casing PVC, 540,
(material) (depth)
(size) If telescope see back.

(5) screen 20', 540'
(length) (depth to top)

2", PVC
(size) (material)

(6) pump 1, 19
(HP) (yield gpm)
E
(type power)

(7) electric log
(yes or no)
(organization running log)

(8) how well bottom plugged By
well

DRILLERS REMARKS:


220' 4"
300' 2"
20' 2" SCREEN

RECEIVED
MAY 22 1986

Department of Natural Resources
Bureau of Land & Water Resources

If well telescopes please sketch and show depths.

GROUND LEVEL

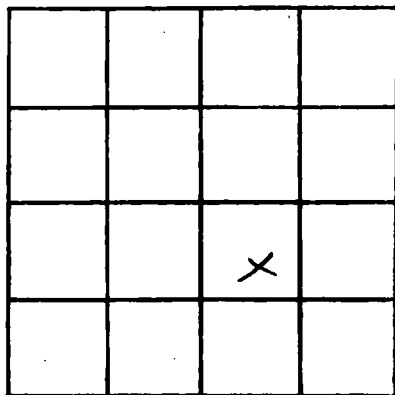

SECTION 36

Please indicate well location X.

ADDITIONAL INFORMATION

If more than one screen, show locations of each on sketch.