

MISSISSIPPI DEPARTMENT OF NATURAL RESOURCES
Bureau of Land and Water Resources
 Southport Mall
 P.O. Box 10631
 Jackson, Mississippi 39209
WATER WELL DRILLERS LOG

HARRISON
F
2056

8-19-86
 date well completed

R Moore Well Drilling
 firm name

HARRISON
 county well located

LANDOWNER: NICIE MAJOLE
LOT 46
TWIN LAKES RD +
SHAW RD
Chester, MS
 (mailing address)

description of formations encountered	from	to
TOP SOIL	0	20
White Clay	20	60
Blue Clay	60	140
Red Sh-2	140	160
Blue Clay	160	290
Coarse Sand	290	320

WELL LOCATION:
 sec. 3 T. 6 N. R. 12 E. S. 5 W. 4 miles E of LIZIBONA
 (distance) (direction) (nearest town)

WELL PURPOSE:
 (home) irrigation, municipal, industrial

- WELL COMPLETION DATA:
- (1) diameter (inches) 2"
 - (2) total depth (feet) 320'
 - (3) static water level (feet) 60' below above top of ground.
 - (4) casing Pvc, 320
 (material) (depth)
 (size) if telescope see back.
 - (5) screen 10', 320
 (length) (depth to top)
2", Pvc
 (size) (material)
 - (6) pump 1 (HP) 8 (yield gpm)
E (type power)
 - (7) electric log _____
 (yes or no)
 _____ (organization running log)
 - (8) how well bottom plugged Bottom


RECEIVED
 AUG 29 1986

Department of Natural Resources
 Bureau of Land & Water Resources

DRILLERS REMARKS: _____

If well telescopes please sketch and show depths.

GROUND LEVEL

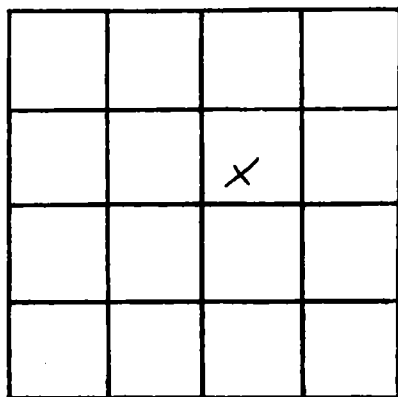

SECTION 3

Please indicate well location X.

ADDITIONAL INFORMATION

If more than one screen,
show locations of each on sketch.