

MISSISSIPPI DEPARTMENT OF NATURAL RESOURCES

Bureau of Land and Water Resources

P.O. Box 10631

Jackson, Mississippi 39209

WATER WELL DRILLERS LOG

COUNTY WELL LOCATED <i>Harrison</i>	
WELL NUMBER <i>F 2060</i>	CODED
DATE WELL COMPLETED <i>10-3-87</i>	

PERMIT NUMBER
NAME OF DRILLING FIRM <i>Mo B Drilling Co.</i>

NAME & MAILING ADDRESS OF LANDOWNER <i>Ricky Campbell</i>			
<i>18304 Saucier Lizana Rd.</i>			
<i>Saucier, Miss - 39574</i>			
WELL LOCATION:	SEC	TOWNSHIP	RANGE
	<i>6</i>	<i>6</i>	<i>S 12 W</i>
DISTANCE	DIRECTION	NEAREST TOWN	
<i>1</i> Miles	<i>NE</i>	of <i>Lizana</i>	
OTHER LANDMARK			
WELL PURPOSE: Home, Irrigation, Municipal, Industrial, Fish Pond, etc. <i>Home</i>			

PUMP DATA		
PUMP TYPE (Circle One): Submersible, Turbine, <input checked="" type="radio"/> <i>Jet</i> Flowing Well, Other (Describe) _____		
POWER TYPE (Circle One): <input checked="" type="radio"/> <i>Electric</i> Tractor, Diesel, Gasoline, Butane, Other (Describe) _____		
Pump Capacity (GPM) <i>8</i>	No. of Stages <i>2</i>	Setting Depth <i>70</i> FT.
PUMP TEST		
Well yielded _____ GPM with a drawdown of _____ ft. after _____ hours of pumping		

WELL DATA		
Well Depth <i>470</i>	Casing Diameter (In.) <i>2 1/4</i>	Casing Length (Ft.) <i>408</i>
Type of Casing <i>PVC</i>	Hole Depth <i>470</i>	Depth to Static Water Level <i>52 FT</i>
TYPE OF COMPLETION: (Circle One or More): <input checked="" type="checkbox"/> <i>Gravel Packed</i> , <input type="checkbox"/> Underreamed, <input type="checkbox"/> Telescoped, <input checked="" type="checkbox"/> <i>Natural Development</i> , <input type="checkbox"/> Open Hole, <input type="checkbox"/> Other (Describe) _____		
Top of Lap Pipe or Reduction in Casing		
FEET <input type="checkbox"/> IF TELESCOPED OR MORE THAN ONE SCREEN: USE BACK PAGE		

LOG DATA	
TYPE OF LOG RUN (Circle One): Electric, Gamma Ray, Density, Sonic, <input checked="" type="radio"/> <i>No Log Run</i> , Neutron, Other (Describe) _____	
Name of Organization Running Log	

SCREEN DATA		
Diameter - Inches <i>2</i>	Length - Feet <i>10</i>	Slot Size - Inches <i>1.008</i>
Screen Type <i>PVC WOP</i>	Depth to Bottom - Feet <i>418</i>	

GEOLOGIC DATA (Office Use Only)			
Surface Elev.	Geologic Unit	Unit Thickness	Depth to Top
Subs. SWL	Date	Analysis	Aquifer Test
Driller's Remarks <i>2 FT Tail pipe</i>			


DESCRIPTION OF FORMATIONS ENCOUNTERED	FROM	TO
<i>Surface</i>	<i>0</i>	<i>8</i>
<i>Sand & Clay</i>	<i>8</i>	<i>110</i>
<i>Blue Clay</i>	<i>110</i>	<i>370</i>
<i>Grey Sand</i>	<i>370</i>	<i>418</i>
<i>Blue Clay</i>	<i>418</i>	<i>470</i>

FORMATIONS (Continued)	FROM	TO
RECEIVED		
<i>FEB 22 1988</i>		
<i>Department of Natural Resources Bureau of Land & Water Resources</i>		

IF MORE SPACE IS NEEDED, USE BACK

If well telescopes please sketch and show depths.

GROUND LEVEL

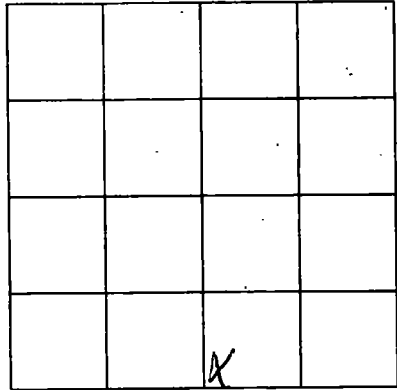

SECTION 6

Please indicate well location X.

ADDITIONAL INFORMATION

If more than one screen,
show location of each on sketch.