




If well telescopes please sketch and show depths.

GROUND LEVEL

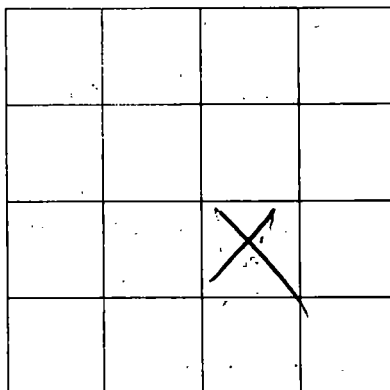

SECTION \_\_\_\_\_

Please indicate well location X.

ADDITIONAL INFORMATION

UNIVERSITY

1981 2 1 1981

UNIVERSITY OF CALIFORNIA  
SCHOOL OF CIVIL AND ENVIRONMENTAL ENGINEERING

If more than one screen,  
show location of each on sketch.