

MISSISSIPPI DEPARTMENT OF NATURAL RESOURCES

Bureau of Land and Water Resources

Southport Mall

P.O. Box 10631

Jackson, Mississippi 39209

WATER WELL DRILLERS LOG

HARRISON
F 2087

8/29/86 19 Lyman Well Harrison
date well completed firm name county well located

LANDOWNER: Robert Jamison
Rt. 1, Box 470 A/4
Saucier Ms 39574
(mailing address)

Description of formations encountered	from	to
Top soil		1-
Sandy Clay	1-	15-
Same	15-	19-
Clay	19-	67-
Same	67-	87-
Blue Clay	87-	182-
Same	182-	188-
Blue Clay	188-	348-
Same	348-	364-

WELL LOCATION:
sec. 3 T. 6 N R. 12 E
15 miles North of Cullman
(distance) (direction) (nearest town)

WELL PURPOSE: Home
(home, irrigation, municipal, industrial)

- WELL COMPLETION DATA:
- (1) diameter (inches) 2"
 - (2) total depth (feet) 364'
 - (3) static water level (feet) 70' ^{below} ~~above~~ top of ground.
 - (4) casing PVC, 354'
(material) (depth)
2" If telescope see back.
(size)
 - (5) screen 10', 354'
(length) (depth to top)
2", PVC
(size) (material)
 - (6) pump electric (HP) (yield gpm)
(type power)
 - (7) electric log NO (yes or no)
NO
(organization running log)
 - (8) how well bottom plugged sand
shark

RECEIVED


OCT 28 1986

Department of Natural Resources
Bureau of Land & Water Resources

DRILLERS REMARKS: None

If well telescopes please sketch and show depths.

GROUND LEVEL

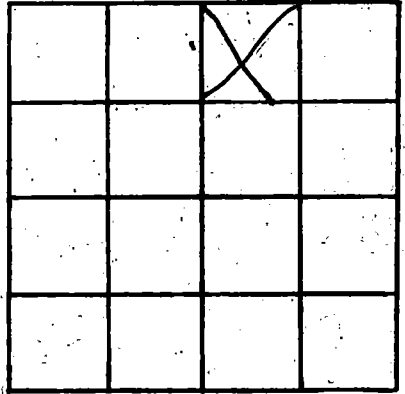

SECTION 3

Please indicate well location X.

ADDITIONAL INFORMATION

If more than one screen,
show locations of each on sketch.