

MISSISSIPPI DEPARTMENT OF NATURAL RESOURCES
Bureau of Land and Water Resources

P.O. Box 10631

Jackson, Mississippi 39209

WATER WELL DRILLERS LOG

COUNTY WELL LOCATED HARRISON	
WELL NUMBER F 2089	CODED
DATE WELL COMPLETED 2-18-87	

PERMIT NUMBER 0239
NAME OF DRILLING FIRM MCGILL PUMP & WELLS
RT1 BOX 1643 CANAL RD GUPT, MS 39503

NAME & MAILING ADDRESS OF LANDOWNER Tommy Moulton #36 WEST Echo Hills apt. ma		
WELL LOCATION: SEC	TOWNSHIP	RANGE
35	6	N 12 E
DISTANCE	DIRECTION	NEAREST TOWN
6 Miles	n/w of	apt.
OTHER LANDMARK 2 miles north I-10 Crngt		
WELL PURPOSE (Home Irrigation, Municipal, Industrial, Fish Pond, etc.) <input checked="" type="checkbox"/> Home		

PUMP DATA		
PUMP TYPE (Circle One): <input checked="" type="checkbox"/> Submersible Turbine Jet Flowing Well, Other (Describe) _____		
POWER TYPE (Circle One): <input checked="" type="checkbox"/> Electric Tractor, Diesel, Gasoline, Butane, Other (Describe) _____		
Pump Capacity (GPM) 18	No. of Stages	Setting Depth 140' FT.
PUMP TEST		
Well yielded 18 GPM with a drawdown of 10 ft. after 1 hours of pumping		

WELL DATA		
Well Depth 560'	Casing Diameter (In.) 4" X 2"	Casing Length (Ft.) 540'
Type of Casing PVC	Hole Depth 560	Depth to Static Water Level 90'
TYPE OF COMPLETION: (Circle One or More): <input checked="" type="checkbox"/> Gravel Packed, <input type="checkbox"/> Underreamed, <input type="checkbox"/> Telescoped, <input checked="" type="checkbox"/> Natural Development, <input type="checkbox"/> Open Hole, <input type="checkbox"/> Other (Describe) _____		
Top of Lap Pipe or Reduction in Casing 200'-4" 360'-2" FEET		
IF TELESCOPED OR MORE THAN ONE SCREEN: USE BACK PAGE		

LOG DATA	
TYPE OF LOG RUN (Circle One): <input checked="" type="checkbox"/> No Log Run Electric, Gamma Ray, Density, Sonic, Neutron, Other (Describe) _____	
Name of Organization Running Log	

SCREEN DATA		
Diameter - Inches 2"	Length - Feet 20'	Slot Size - Inches 6/75
Screen Type PVC-sch 80	Depth to Bottom - Feet 560'	

GEOLOGIC DATA (Office Use Only)			
Surface Elev.	Geologic Unit	Unit Thickness	Depth to Top
Subs. SWL	Date	Analysis	Aquifer Test
Driller's Remarks			

RECEIVED

APR 14 1987


DESCRIPTION OF FORMATIONS ENCOUNTERED	FROM	TO	FORMATIONS ENCOUNTERED	FROM	TO
Sand	0	10			
mud	10	90			
Sand	90	160			
mud	160	460			
Sand	460	480			
mud	480	510			
Sand	510	560			

Department of Natural Resources
Bureau of Land & Water Resources

IF MORE SPACE IS NEEDED, USE BACK

If well telescopes please sketch and show depths.

GROUND LEVEL

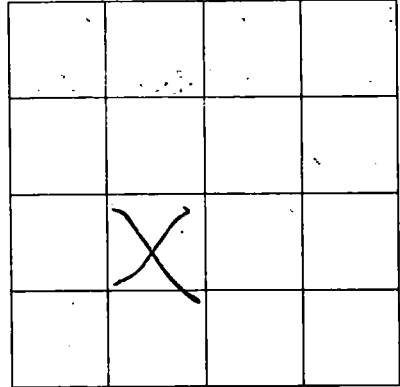

SECTION _____

Please indicate well location X.

ADDITIONAL INFORMATION

If more than one screen,
show location of each on sketch.