

# MISSISSIPPI DEPARTMENT OF NATURAL RESOURCES

Bureau of Land and Water Resources

COUNTY WELL LOCATED <i>Harrison</i>	
WELL NUMBER <i>F 2094</i>	CODED <i>2</i>
DATE WELL COMPLETED <i>MARCH 12-87</i>	

PERMIT NUMBER <i>0-239</i>
NAME OF DRILLING FIRM <b>MCGILL PUMP &amp; WELLS</b> <b>RT1 BOX 1643 CANAL RD</b> <b>GUPT, MS 39503</b>

P.O. Box 10631  
Jackson, Mississippi 39209  
WATER WELL DRILLERS LOG

NAME & MAILING ADDRESS OF LANDOWNER <i>Mary Shihodeaux</i> <i>2323-29th St.</i>			
WELL LOCATION:    SEC    TOWNSHIP    RANGE <i>-    11    6    N    12    E    W</i>			
DISTANCE                  DIRECTION                  NEAREST TOWN <i>5</i> Miles <i>West</i> of <i>Hot</i>			
OTHER LANDMARK			
WELL PURPOSE: Home, Irrigation, Municipal, Industrial, Fish Pond, etc. <i>HEAT &amp; Air Pump</i>			

PUMP DATA		
PUMP TYPE (Circle One): Submersible, Turbine, Jet, Flowing Well, Other (Describe) <u><i>1/2 hp pump</i></u>		
POWER TYPE (Circle One): <u><i>Electric</i></u> Tractor, Diesel, Gasoline, Butane, Other (Describe)		
Pump Capacity (GPM) <i>8</i>	No. of Stages <i>1</i>	Setting Depth <i>20'</i> FT.
PUMP TEST		
Well yielded <u><i>8</i></u> GPM with a drawdown of <u><i>5</i></u> ft. after <u><i>1</i></u> hours of pumping		

WELL DATA		
Well Depth <i>80'</i>	Casing Diameter (In.) <i>2"</i>	Casing Length (Ft.) <i>70'</i>
Type of Casing <i>PVC</i>	Hole Depth <i>80'</i>	Depth to Static Water Level <i>1" Above grd.</i>
TYPE OF COMPLETION: (Circle One or More): <u><i>Natural Development</i></u> , Gravel Packed, Underreamed, Telescoped, Open Hole, Other		
Top of Lap Pipe or Reduction in Casing		
FEET          IF TELESCOPED OR MORE THAN ONE SCREEN: USE BACK PAGE		

LOG DATA
TYPE OF LOG RUN (Circle One): Electric, Gamma Ray, Density, Sonic, <u><i>No Log Run</i></u> , Neutron, Other (Describe)
Name of Organization Running Log

SCREEN DATA		
Diameter - Inches <i>2"</i>	Length - Feet <i>10'</i>	Slot Size - Inches <i>8ths</i>
Screen Type <i>PVC - Sch 80</i>		Depth to Bottom - Feet <i>80'</i>

GEOLOGIC DATA (Office Use Only)			
Surface Elev.	Geologic Unit	Unit Thickness	Depth to Top
Subs. SWL	Date	Analysis	Aquifer Test
Driller's Remarks			

DESCRIPTION OF FORMATIONS ENCOUNTERED	FROM	TO	FORMATIONS (Continued)	FROM	TO
<i>Mud</i>	<i>0"</i>	<i>20</i>			
<i>Sand/Gravel</i>	<i>20</i>	<i>80</i>			
IF MORE SPACE IS NEEDED, USE BACK					


RECEIVED

MAY 27 1987

Department of Natural Resources  
Bureau of Land & Water Resources

If well telescopes please sketch and show depths.

GROUND LEVEL

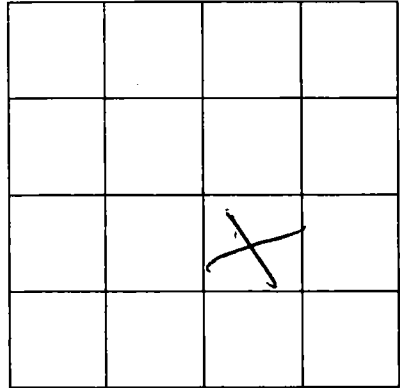

SECTION \_\_\_\_\_

Please indicate well location X.

ADDITIONAL INFORMATION

If more than one screen,  
show location of each on sketch.