

**MISSISSIPPI DEPARTMENT OF NATURAL RESOURCES**  
Bureau of Land and Water Resources

P.O. Box 10631  
Jackson, Mississippi 39209  
**WATER WELL DRILLERS LOG**

COUNTY WELL LOCATED <u>Harrison</u>	
WELL NUMBER <u>F 2095</u>	CODED
DATE WELL COMPLETED <u>May 6-1987</u>	

PERMIT NUMBER <u>D-239</u>
NAME OF WELL IN PUMP & WELLS <u>RT1 BOX 1643 CANAL RD</u> <u>GUPT, MS 39503</u>

NAME & MAILING ADDRESS OF LANDOWNER <u>Chris Burch</u> <u>19163 Mary Shannis</u> <u>Saucier, Ms.</u>		
WELL LOCATION: SEC	TOWNSHIP	RANGE
<u>2</u>	<u>6</u>	<u>12</u>
DISTANCE DIRECTION NEAREST TOWN <u>5</u> Miles <u>NW</u> of <u>Syman</u>		
OTHER LANDMARK		
WELL PURPOSE: <input checked="" type="checkbox"/> Home <input type="checkbox"/> Irrigation, Municipal, Industrial, Fish Pond, etc.		

<b>PUMP DATA</b>		
PUMP TYPE (Circle One): Submersible, Turbine, <input checked="" type="radio"/> Jet, Flowing Well, Other (Describe) _____		
POWER TYPE (Circle One): <input checked="" type="radio"/> Electric, Tractor, Diesel, Gasoline, Butane, Other (Describe) _____		
Pump Capacity (GPM) <u>10-15</u>	No. of Stages <u>2</u>	Setting Depth   <b>FT.</b>
PUMP TEST		
Well yielded <u>2</u> GPM with a drawdown of <u>8</u> ft. after <u>1</u> hours of pumping		

<b>WELL DATA</b>		
Well Depth <u>400'</u>	Casing Diameter (In.) <u>2"</u>	Casing Length (Ft.) <u>20'</u>
Type of Casing <u>PVC</u>	Hole Depth <u>400'</u>	Depth to Static Water Level <u>80'</u>
TYPE OF COMPLETION: (Circle One or More): <input type="checkbox"/> Gravel Packed, <input type="checkbox"/> Underreamed, <input type="checkbox"/> Telescoped, <input checked="" type="checkbox"/> Natural Development, <input type="checkbox"/> Open Hole, <input type="checkbox"/> Other (Describe) _____		
Top of Lap Pipe or Reduction in Casing		
FEET	IF TELESCOPED OR MORE THAN ONE SCREEN: USE BACK PAGE	

<b>LOG DATA</b>	
TYPE OF LOG RUN (Circle One): <input checked="" type="checkbox"/> No Log Run, <input type="checkbox"/> Electric, Gamma Ray, Density, Sonic, Neutron, Other (Describe) _____	
Name of Organization Running Log	

<b>SCREEN DATA</b>		
Diameter - inches <u>2"</u>	Length - Feet <u>10'</u>	Slot Size - inches <u>1,000/6</u>
Screen Type <u>Dch 80 PVC</u>	Depth to Bottom - Feet <u>380'</u>	


<b>GEOLOGIC DATA (Office Use Only)</b>			
Surface Elev.	Geologic Unit	Unit Thickness	Depth to Top
Subs. SWL	Date	Analysis	Aquifer Test

Driller's Remarks

DESCRIPTION OF FORMATIONS ENCOUNTERED	FROM	TO	FORMATIONS (Continued)	FROM	TO
<u>Mud</u>	<u>0</u>	<u>10</u>	<div style="font-size: 2em; font-weight: bold; border: 2px solid black; padding: 5px; display: inline-block;">RECEIVED</div>  <div style="font-size: 1.5em; font-weight: bold;">MAY 27 1987</div>		
<u>Sand</u>	<u>10</u>	<u>40</u>			
<u>Mud</u>	<u>40</u>	<u>160</u>			
<u>Sand</u>	<u>160</u>	<u>180</u>			
<u>Mud</u>	<u>180</u>	<u>280</u>			
<u>Sand</u>	<u>280</u>	<u>300</u>			
<u>Mud</u>	<u>300</u>	<u>350</u>			
<u>Sand</u>	<u>350</u>	<u>380</u>			
			<b>Department of Natural Resources</b> <b>Bureau of Land &amp; Water Resources</b>		
IF MORE SPACE IS NEEDED, USE BACK					

If well telescopes please sketch and show depths.

GROUND LEVEL

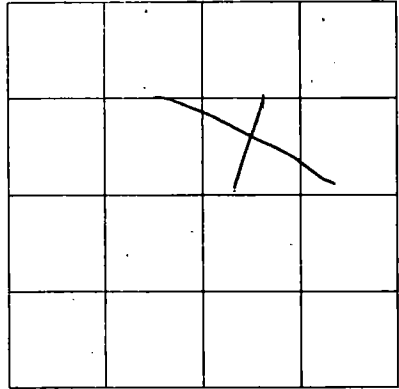

SECTION \_\_\_\_\_

Please indicate well location X.

ADDITIONAL INFORMATION

If more than one screen,  
show location of each on sketch.