

MISSISSIPPI DEPARTMENT OF NATURAL RESOURCES
Bureau of Land and Water Resources

P.O. Box 10631
Jackson, Mississippi 39209
WATER WELL DRILLERS LOG

COUNTY WELL LOCATED Harrison	
WELL NUMBER F 2099	CODED
DATE WELL COMPLETED 9/20/86	

PERMIT NUMBER
NAME OF DRILLING FIRM Lyman Well Co.

NAME & MAILING ADDRESS OF LANDOWNER Darlene Anderson			
Rt. 3, Box 109-F			
Gulfport, MS 39503			
WELL LOCATION	SEC	TOWNSHIP	RANGE
	11	6	12 ^N _W
DISTANCE	DIRECTION	NEAREST TOWN	
10 Miles	North	Long Beach	
OTHER LANDMARK			
WELL PURPOSE: <input checked="" type="radio"/> Home, <input type="radio"/> Irrigation, <input type="radio"/> Municipal, <input type="radio"/> Industrial, <input type="radio"/> Fish Pond, etc.			

PUMP DATA		
PUMP TYPE (Circle One): Submersible, Turbine, <input checked="" type="radio"/> Jet, Flowing Well, Other (Describe) _____		
POWER TYPE (Circle One): <input checked="" type="radio"/> Electric, Tractor, Diesel, Gasoline, Butane, Other (Describe) _____		
Pump Capacity (GPM) 12	No. of Stages 2	Setting Depth 60 FT.
PUMP TEST		
Well yielded 11 GPM with a drawdown of N/A ft. after _____ hours of pumping		

WELL DATA		
Well Depth 323'	Casing Diameter (In.) 2"	Casing Length (Ft.) 313'
Type of Casing PVC	Hole Depth 323'	Depth to Static Water Level 31'
TYPE OF COMPLETION: (Circle One or More): <input checked="" type="radio"/> Gravel Packed, <input type="radio"/> Underreamed, <input type="radio"/> Telescoped, <input checked="" type="radio"/> Natural Development, <input type="radio"/> Open Hole, <input type="radio"/> Other (Describe) _____		
Top of Lap Pipe or Reduction in Casing		
FEET	IF TELESCOPED OR MORE THAN ONE SCREEN: USE BACK PAGE	

LOG DATA	
TYPE OF LOG RUN (Circle One): Electric, Gamma Ray, Density, Sonic, Neutron, Other (Describe) _____	
Name of Organization Running Log	

SCREEN DATA		
Diameter - Inches 2"	Length - Feet 10'	Slot Size - Inches .006
Screen Type PVC-sawed	Depth to Bottom - Feet 323'	

GEOLOGIC DATA (Office Use Only)			
Surface Elev.	Geologic Unit	Unit Thickness	Depth to Top
Subs. SWL	Date	Analysis	Aquifer Test
Driller's Remarks None			


DESCRIPTION OF FORMATIONS ENCOUNTERED	FROM	TO	FORMATIONS ENCOUNTERED FROM	TO
Topsoil		1'		
sandy clay	1'	4'		
Clay	4'	28'		
Red Sand	28'	85'		
Blue Clay	85'	95'		
Sand	95'	107'		
Blue Clay	107'	289'		
Sand	289'	323'		

RECEIVED
AUG 25 1987
Department of Natural Resources
Bureau of Land & Water Resources

IF MORE SPACE IS NEEDED, USE BACK

If well telescopes please sketch and show depths.

GROUND LEVEL

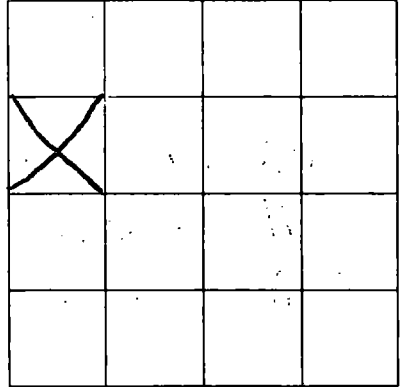

SECTION 11

Please indicate well location X.

ADDITIONAL INFORMATION

If more than one screen,
show location of each on sketch.