

# MISSISSIPPI DEPARTMENT OF NATURAL RESOURCES

Bureau of Land and Water Resources

P.O. Box 10631

Jackson, Mississippi 39209

## WATER WELL DRILLERS LOG

COUNTY WELL LOCATED <b>Harrison</b>	
WELL NUMBER <b>F 2003</b>	CODED
DATE WELL COMPLETED <b>June 25-87</b>	

PERMIT NUMBER <b>0239</b>
NAME OF DRILLING FIRM <b>Mobile Pump &amp; Well</b>
<b>1643 God Canal rd. Gpt.</b>

NAME & MAILING ADDRESS OF LANDOWNER <b>Edward Anderson</b>		
<b>14263 John Clark</b>		
<b>Gpt. Ms</b>		
WELL LOCATION: SEC	TOWNSHIP	RANGE
<b>36</b>	<b>6</b>	<b>N 12 E</b>
DISTANCE	DIRECTION	NEAREST TOWN
<b>5</b> Miles	<b>West</b> of	<b>N. Gpt.</b>
OTHER LANDMARK		
WELL PURPOSE: <input checked="" type="checkbox"/> Home Irrigation, <input type="checkbox"/> Municipal, <input type="checkbox"/> Industrial, <input type="checkbox"/> Fish Pond, etc.		

PUMP DATA		
PUMP TYPE (Circle One): <input checked="" type="radio"/> Submersible <input type="radio"/> Turbine, <input type="radio"/> Jet <input type="radio"/> Flowing Well, Other (Describe) _____		
POWER TYPE (Circle One): <input type="radio"/> Electric, <input type="radio"/> Tractor, <input type="radio"/> Diesel, <input type="radio"/> Gasoline, <input type="radio"/> Butane, Other (Describe) _____		
Pump Capacity (GPM) <b>18</b>	No. of Stages	Setting Depth <b>126</b> FT.
PUMP TEST		
Well yielded <b>18</b> GPM with a drawdown of <b>15</b> ft. after <b>1</b> hours of pumping		

WELL DATA		
Well Depth <b>500</b>	Casing Diameter (In.) <b>4" X 20"</b>	Casing Length (Ft.) <b>500</b>
Type of Casing <b>PVC</b>	Hole Depth <b>500</b>	Depth to Static Water Level <b>90</b>
TYPE OF COMPLETION: (Circle One or More): <input checked="" type="checkbox"/> Gravel Packed <input type="checkbox"/> Underreamed, <input type="checkbox"/> Telescoped, <input checked="" type="checkbox"/> Natural Development <input type="checkbox"/> Open Hole, <input type="checkbox"/> Other (Describe) _____		
Top of Lap Pipe or Reduction in Casing		
FEET    IF TELESCOPED OR MORE THAN ONE SCREEN: USE BACK PAGE		

LOG DATA	
TYPE OF LOG RUN (Circle One): <input type="radio"/> Electric, <input type="radio"/> Gamma Ray, <input type="radio"/> Density, <input type="radio"/> Sonic, <input type="radio"/> Neutron, Other (Describe) _____	
<input checked="" type="radio"/> No Log Run	
Name of Organization Running Log	

SCREEN DATA		
Diameter - Inches <b>2"</b>	Length - Feet <b>20'</b>	Slot Size - Inches <b>.0006</b>
Screen Type <b>PVC</b>		Depth to Bottom - Feet <b>500</b>


GEOLOGIC DATA (Office Use Only)			
Surface Elev.	Geologic Unit	Unit Thickness	Depth to Top
Subs. SWL	Date	Analysis	Aquifer Test
Driller's Remarks			

DESCRIPTION OF FORMATIONS ENCOUNTERED	FROM	TO	FORMATIONS (continued)
<b>Sand</b>	<b>0</b>	<b>60</b>	<div style="font-size: 2em; font-weight: bold; opacity: 0.5;">RECEIVED</div> <p style="font-size: 1.5em; font-weight: bold;">AUG 14 1987</p> <p style="font-size: 1em;">Department of Natural Resources Bureau of Land &amp; Water Resources</p>
<b>Mud</b>	<b>60</b>	<b>200</b>	
<b>Sand</b>	<b>200</b>	<b>230</b>	
<b>Mud</b>	<b>230</b>	<b>480</b>	
<b>Sand</b>	<b>480</b>	<b>500</b>	

IF MORE SPACE IS NEEDED, USE BACK

If well telescopes please  
sketch and show depths.

GROUND LEVEL

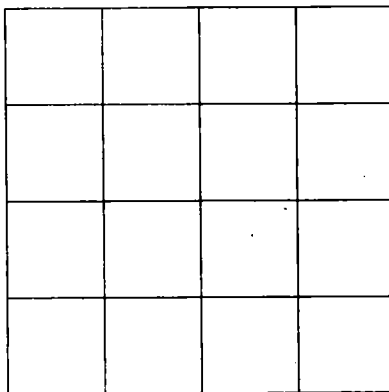

SECTION \_\_\_\_\_

Please indicate well location X.

ADDITIONAL INFORMATION

If more than one screen,  
show location of each on sketch.