

MISSISSIPPI DEPARTMENT OF NATURAL RESOURCES

Bureau of Land and Water Resources

Southport Mall

P.O. Box 10631

Jackson, Mississippi 39209

WATER WELL DRILLERS LOG

HARRISON
F 2104

5-16-87 19
date well completed

R. J. Moore
firm name

HARRISON
county well located

LANDOWNER: MARY BENNET
JOHN CLARK RD
Caulsport, MS
(mailing address)

description of formations encountered	from	to
Red clay + sand	0	20
Red clay	20	40
White + red clay	40	80
Blue clay	80	200
med red sand	200	211

WELL LOCATION:
sec. 23 T 6 N R 12 E
6 miles W of Lumberton
(distance) (direction) (nearest town)

WELL PURPOSE:
(home) irrigation, municipal, industrial

WELL COMPLETION DATA:

- (1) diameter (inches) 2"
- (2) total depth (feet) 211
- (3) static water level (feet) 60' ^{below} above top of ground.
- (4) casing PVC, 211,
(material) (depth)
 If telescope see back.
(size)
- (5) screen 10', 211
(length) (depth to top)
2", PVC
(size) (material)
- (6) pump 1 6
(HP) (yield gpm)
E
(type power)
- (7) electric log
(yes or no)

(organization running log)
- (8) how well bottom plugged

DRILLERS REMARKS:


RECEIVED

NOV 04 1987

Department of Natural Resources
Bureau of Land & Water Resources

If well telescopes please sketch and show depths.

GROUND LEVEL

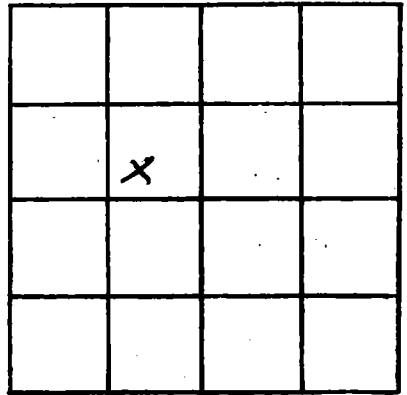

SECTION 23

Please indicate well location X.

ADDITIONAL INFORMATION

If more than one screen,
show locations of each on sketch.