

HARRISON
F 2105

MISSISSIPPI DEPARTMENT OF NATURAL RESOURCES
Bureau of Land and Water Resources
Southport Mall
P.O. Box 10631
Jackson, Mississippi 39209
WATER WELL DRILLERS LOG

11-3-87 19 date well completed
firm name
HARRISON county well located

LANDOWNER: MAE TRUSSSELL
Structure: LIZIANA RD
Structure MS
(mailing address)

WELL LOCATION:
sec. 7 T. 6 N. R. 12 E.
3/4 miles N of Church
(distance) (direction) (nearest town)

WELL PURPOSE:
(home, irrigation, municipal, industrial)

- WELL COMPLETION DATA:
- (1) diameter (inches) 2"
 - (2) total depth (feet) 340'
 - (3) static water level (feet) 70' below top of ground.
 - (4) casing PVC 340' (material) (depth)
 - (size) If telescope see back.
 - (5) screen 10' 340' (length) (depth to top)
 - 2" PVC (size) (material)
 - (6) pump 1 (HP) 6 (yield gpm)
 - E (type power)
 - (7) electric log (yes or no)
 - (organization running log)
 - (8) how well bottom plugged

description of formations encountered	from	to
Top Silt & Clay	0	20
Wh. Re. Clay & Sand	20	40
Wh. Re. Clay	40	100
Fine Sand	100	120
Blue Clay	120	300
Med Sand	300	320
Coke Sand	320	340

RECEIVED


DEC 02 1987

Department of Natural Resources
Bureau of Land & Water Resources

DRILLERS REMARKS:

If well telescopes please
sketch and show depths.

GROUND LEVEL

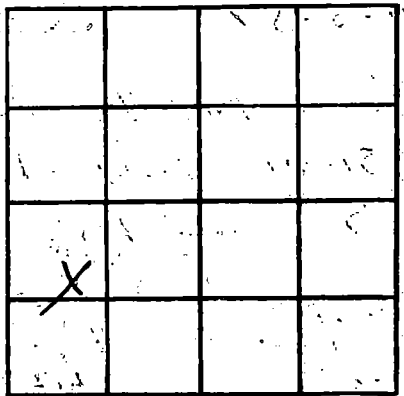

SECTION _____

Please indicate well location X.

ADDITIONAL INFORMATION

If more than one screen,
show locations of each on sketch.