

Harrison
P 2106

MISSISSIPPI DEPARTMENT OF NATURAL RESOURCES
Bureau of Land and Water Resources
Southport Mall
P.O. Box 10631
Jackson, Mississippi 39209
WATER WELL DRILLERS LOG

11-6-87 19 P.V. Moore HARRISON
date well completed firm name county well located

LANDOWNER: MIKE SILLS
14269
WALLACE RD
JOHN CLARIC
COLEMAN, MS
(mailing address)

WELL LOCATION:
sec. 23T 6 N R. 12E
5 miles W of LIMBY
(distance) (direction) (nearest town)

WELL PURPOSE:
(Home, Irrigation, municipal, Industrial)

WELL COMPLETION DATA:
(1) diameter (inches) 2"
(2) total depth (feet) 532'
(3) static water level (feet) 90' below above top of ground.
(4) casing Pvc, 532'
(material) (depth)
(size) If telescope see back.
(5) screen 10', 532'
(length) (depth to top)
2", Pvc
(size) (material)
(6) pump 1 1/2, 6
(HP) (yield gpm)
E
(type power)
(7) electric log _____
(yes or no)
(organization running log)
(8) how well bottom plugged _____
Barre

description of formations encountered	from	to
TOP SOIL & clay	0	20
clay	20	40
Red Sand	40	60
White Clay	60	100
Blue Clay	100	120
Red Sand	120	260
Blue Clay	260	480
Red Sand	480	500
Coarse Sand	500	532

RECEIVED


DEC 02 1987

Department of Natural Resources
Bureau of Land & Water Resources

DRILLERS REMARKS:

If well telescopes please sketch and show depths.

GROUND LEVEL

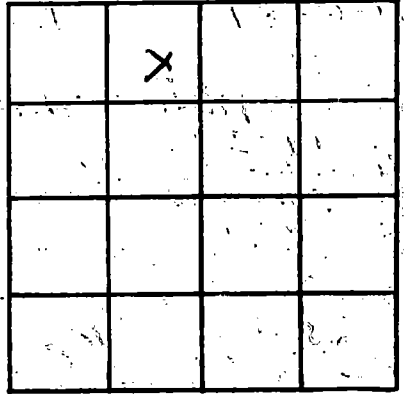

SECTION 25

Please indicate well location X.

ADDITIONAL INFORMATION

[Faint, illegible text]

If more than one screen,
show locations of each on sketch.