

MISSISSIPPI DEPARTMENT OF NATURAL RESOURCES

Bureau of Land and Water Resources

Southport Mall

P.O. Box 10631

Jackson, Mississippi 39209

WATER WELL DRILLERS LOG

Harrison
F2108
0239

January 18 1988 McNeil Pump & Well Harrison
 date well completed firm name county well located

LANDOWNER: Joan Edwards
18559 Pine Forest
Gulfport Ms.
 (mailing address)

WELL LOCATION:
 sec. 35 T. 6 N. R. 12 E.
6 miles WEST of Apt.
 (distance) (direction) (nearest town)

WELL PURPOSE:
 (home, irrigation, municipal, industrial)

WELL COMPLETION DATA: 200'

(1) diameter (inches) 4" x 2" - 320'

(2) total depth (feet) 520'

(3) static water level (feet) 85 ^{below} _{above} top of ground.

(4) casing PVC, 500
 (material) (depth)
4" x 2" if telescope see back.
 (size)

(5) screen 20', 520'
 (length) (depth to top)
2", PVC
 (size) (material)

(6) pump 1 18
 (HP) (yield gpm)
electric
 (power)

(7) c log yes no
 (organization running log)

(8) how well bottom plugged Seal

description of formations encountered	from	to
<u>Mud</u>	<u>0</u>	<u>170</u>
<u>Sand</u>	<u>170</u>	<u>300</u>
<u>Mud</u>	<u>200</u>	<u>360</u>
<u>Sand</u>	<u>360</u>	<u>370</u>
<u>mud</u>	<u>370</u>	<u>490</u>
<u>Sand</u>	<u>490</u>	<u>520</u>

RECEIVED

JAN 27 1988

Department of Natural Resources
 Bureau of Land & Water Resources

DRILLERS REMARKS:

If well telescopes please sketch and show depths.


GROUND LEVEL

200'-Top 4"
320'-Bottom 2"

RECEIVED

U.S. GEOLOGICAL SURVEY
WASHINGTON, D.C. 20540

If more than one screen, show locations of each on sketch.

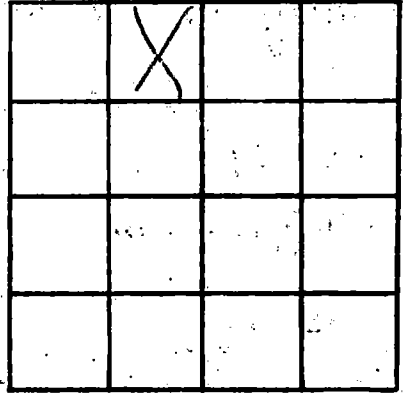

SECTION _____

Please indicate well location X.

ADDITIONAL INFORMATION

Lined area for additional information, containing a large black ink blot.