

MISSISSIPPI DEPARTMENT OF NATURAL RESOURCES

Bureau of Land and Water Resources

P.O. Box 10631
Jackson, Mississippi 39209
WATER WELL DRILLERS LOG

COUNTY WELL LOCATED <u>Harrison</u>	
WELL NUMBER <u>F 2113</u>	CODED
DATE WELL COMPLETED <u>Sept 18-89</u>	

PERMIT NUMBER <u>0239</u>
NAME OF DRILLING FIRM <u>Metall Pump & Well</u>

NAME & MAILING ADDRESS OF LANDOWNER <u>Cable Bridge Rd.</u>		
<u>Ross Christian ms.</u>		
WELL LOCATION: SEC	TOWNSHIP	RANGE
<u>34</u>	<u>6</u>	<u>N 13 W</u>
DISTANCE	DIRECTION	NEAREST TOWN
<u>3</u> Miles	<u>WEST</u>	<u>of Hazara</u>
OTHER LANDMARK		
WELL PURPOSE: <input checked="" type="checkbox"/> Home Irrigation, <input type="checkbox"/> Municipal, <input type="checkbox"/> Industrial, <input type="checkbox"/> Fish Pond, etc.		

PUMP DATA		
PUMP TYPE (Circle One): Submersible, Turbine, <input checked="" type="radio"/> Jet, Flowing Well, Other (Describe) _____		
POWER TYPE (Circle One): <input checked="" type="radio"/> Electric, Tractor, Diesel, Gasoline, Butane, Other (Describe) _____ H/P _____		
Pump Capacity (GPM) <u>9</u>	No. of Stages <u>2</u>	Setting Depth <u>90'</u> FT.
PUMP TEST Well yielded <u>9</u> GPM with a drawdown of <u>8</u> ft. after <u>1</u> hours of pumping		

WELL DATA		
Well Depth <u>360'</u>	Casing Diameter (In.) <u>2"</u>	Casing Length (Ft.) <u>20'</u>
Type of Casing <u>PVC</u>	Hole Depth <u>360'</u>	Depth to Static Water Level <u>70'</u>
TYPE OF COMPLETION: (Circle One or More): <input checked="" type="checkbox"/> Gravel Packed, <input type="checkbox"/> Underreamed, <input type="checkbox"/> Telescoped, <input checked="" type="checkbox"/> Natural Development, <input type="checkbox"/> Open Hole, <input type="checkbox"/> Other (Describe) _____		
Top of Lap Pipe or Reduction in Casing FEET <input type="checkbox"/> IF TELESCOPED OR MORE THAN ONE SCREEN: USE BACK PAGE		

LOG DATA	
TYPE OF LOG RUN (Circle One): Electric, Gamma Ray, Density, Sonic, Neutron, Other (Describe) _____	
Name of Organization Running Log _____	

SCREEN DATA		
Diameter - Inches <u>2"</u>	Length - Feet <u>10'</u>	Slot Size - Inches <u>.0006</u>
Screen Type <u>PVC</u>	Depth to Bottom - Feet <u>360'</u>	

GEOLOGIC DATA (Office Use Only)			
Surface Elev.	Geologic Unit	Unit Thickness	Depth to Top
Subs. SWL	Date	Analysis	Aquifer Test

Driller's Remarks


DESCRIPTION OF FORMATIONS ENCOUNTERED	FROM	TO
<u>sand/gravel</u>	<u>0</u>	<u>50</u>
<u>mud</u>	<u>50</u>	<u>130</u>
<u>sand</u>	<u>130</u>	<u>140</u>
<u>mud</u>	<u>140</u>	<u>280</u>
<u>sand</u>	<u>280</u>	<u>360</u>

FORMATIONS ENCOUNTERED	FROM	TO
RECEIVED		
AUG 16 1990		
Department of Natural Resources Bureau of Land & Water Resources		

IF MORE SPACE IS NEEDED, USE BACK

If well telescopes please
sketch and show depths.

GROUND LEVEL

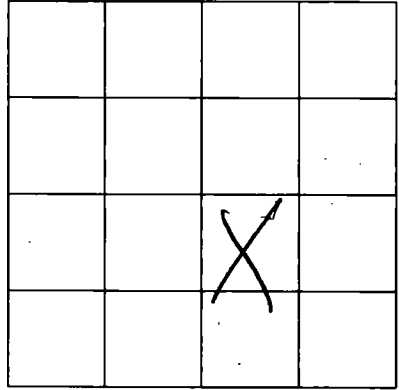

SECTION _____

Please indicate well location X.

ADDITIONAL INFORMATION

If more than one screen,
show location of each on sketch.