

MISSISSIPPI DEPARTMENT OF NATURAL RESOURCES

Bureau of Land and Water Resources

Southport Mall

P.O. Box 10631

Jackson, Mississippi 39209

WATER WELL DRILLERS LOG

Harrison
F 2118

7/25
date well completed

Bud Denton
firm name

Harrison
Harrison
county well located


LANDOWNER: David Lehardt
24540 Hwy 53
Socia Miss.
(mailing address)

description of formations encountered	from	to
	<u>Red shale</u>	<u>0</u>
<u>Red sand</u>	<u>25</u>	<u>70</u>
<u>Blue shale</u>	<u>70</u>	<u>150</u>
<u>Red sand</u>	<u>150</u>	<u>235</u>
<u>Blue shale</u>	<u>235</u>	<u>500</u>
<u>Gray sand</u>	<u>500</u>	<u>630</u>

WELL LOCATION:
sec. 16 T. 6 N. R. 12 E.
8 miles W of Socia
(distance) (direction) (nearest town)

WELL PURPOSE: home
(home, irrigation, municipal, industrial)

- WELL COMPLETION DATA:
- (1) diameter (inches) 4 X 2
 - (2) total depth (feet) 630
 - (3) static water level (feet) 138 below top of ground.
 - (4) casing PVC (material), 530 (depth)
 - 4 X 2 (size) If telescope see back.
 - (5) screen 10 (length), 530 (depth to top)
 - 12 (size), PVC (material)
 - (6) pump 1 (HP), 11 (yield gpm)
 - Elect (type power)
 - (7) electric log no (yes or no)
 - (organization running log)
 - (8) how well bottom plugged good

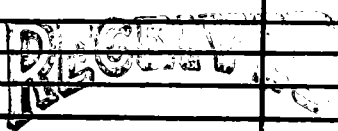


OCT 15 1990

Department of Natural Resources
Bureau of Land & Water

DRILLERS REMARKS:

If well telescopes please sketch and show depths.

GROUND LEVEL

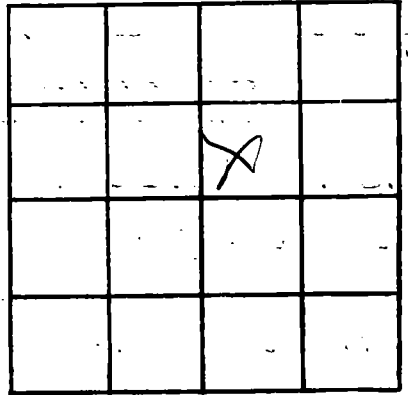

SECTION _____

Please indicate well location X.

ADDITIONAL INFORMATION

If more than one screen,
show locations of each on sketch.