

MISSISSIPPI DEPARTMENT OF NATURAL RESOURCES
Bureau of Land and Water Resources

P.O. Box 10631
Jackson, Mississippi 39209
WATER WELL DRILLERS LOG

COUNTY WELL LOCATED HARRISON	
WELL NUMBER 6F	CODED 2123
DATE WELL COMPLETED 8-6-90	

PERMIT NUMBER 404
NAME OF DRILLING FIRM Lyman Well Co.
Gulfport, Ms

NAME & MAILING ADDRESS OF LANDOWNER Orange Grove Utilities P.O. Box 2969 Orange Grove Utilities Gulfport Ms 39503 Deucier 6 12W 6S		
WELL LOCATION: SEC	TOWNSHIP	RANGE
6	6	N 12 E
DISTANCE	DIRECTION	NEAREST TOWN
_____ Miles	_____ of _____	_____
OTHER LANDMARK		
WELL PURPOSE: Home, Irrigation, Municipal, Industrial, Fish Pond, etc.		

PUMP DATA		
PUMP TYPE (Circle One): <u>Submersible</u> Turbine, Jet, Flowing Well, Other (Describe) _____		
POWER TYPE (Circle One): Electric, Tractor, Diesel, Gasoline, Butane, Other (Describe) _____ H/P 3		
Pump Capacity (GPM) 100	No. of Stages 12	Setting Depth 100 FT.
PUMP TEST		
Well yielded _____ GPM with a drawdown of _____ ft. after _____ hours of pumping		

WELL DATA		
Well Depth 494'	Casing Diameter (In.) 4"	Casing Length (Ft.) 474'
Type of Casing PUC	Hole Depth	Depth to Static Water Level
TYPE OF COMPLETION: (Circle One or More): Gravel Packed, Underreamed, Telescoped, Natural Development, Open Hole, Other (Describe) _____		
Top of Lap Pipe or Reduction in Casing NA FEET IF TELESCOPED OR MORE THAN ONE SCREEN: USE BACK PAGE		

LOG DATA	
TYPE OF LOG RUN (Circle One): Electric, Gamma Ray, Density, Sonic, Neutron, Other (Describe) _____ No Log Run.	
Name of Organization Running Log	

SCREEN DATA		
Diameter - Inches 4"	Length - Feet 20'	Slot Size - Inches
Screen Type PUC		Depth to Bottom - Feet

GEOLOGIC DATA (Office Use Only)			
Surface Elev.	Geologic Unit	Unit Thickness	Depth to Top
Subs. SWL	Date	Analysis	Aquifer Test
Driller's Remarks			

DESCRIPTION OF FORMATIONS ENCOUNTERED	FROM	TO
Top soil	0	30
yellow clay	3	10
sand gravel	10	40
clay	40	410
soil gravel	410	494

FORMATIONS (Continued)	FROM	TO
RECEIVED		
OCT 23 1990		
Department of Natural Resources Bureau of Land & Water Resources		

IF MORE SPACE IS NEEDED, USE BACK


If well telescopes please sketch and show depths.

GROUND LEVEL

SECTION _____

Please indicate well location X.

ADDITIONAL INFORMATION

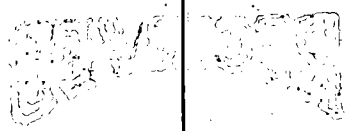

Small text or signature at the bottom of the sketch area.

If more than one screen, show location of each on sketch.