

MISSISSIPPI DEPARTMENT OF NATURAL RESOURCES
Bureau of Land and Water Resources

P.O. Box 10631
Jackson, Mississippi 39209
WATER WELL DRILLERS LOG

COUNTY WELL LOCATED HARRISON	
WELL NUMBER F 2129	CODED
DATE WELL COMPLETED 12-2-89	

PERMIT NUMBER 0039
NAME OF DRILLING FIRM McMill

NAME & MAILING ADDRESS OF LANDOWNER Bonnie Broadus		
Joscow rd.		
Mtpt Ms. 39505		
WELL LOCATION: SEC	TOWNSHIP	RANGE
12	6	12
DISTANCE	DIRECTION	NEAREST TOWN
4 Miles	South	Lizana
OTHER LANDMARK		
WELL PURPOSE <input checked="" type="checkbox"/> Home Irrigation, Municipal, Industrial, Fish Pond, etc.		

PUMP DATA		
PUMP TYPE (Circle One): Submersible, Turbine, <input checked="" type="radio"/> Jet, Flowing Well, Other (Describe) _____		
POWER TYPE (Circle One): <input checked="" type="radio"/> Electric, Tractor, Diesel, Gasoline, Butane, Other (Describe) _____ H/P _____		
Pump Capacity (GPM) 10	No. of Stages 2	Setting Depth 70 FT.
PUMP TEST		
Well yielded 10 GPM with a drawdown of 10 ft. after 1 hours of pumping		

WELL DATA		
Well Depth 360'	Casing Diameter (In.) 2	Casing Length (Ft.) 350
Type of Casing PVC	Hole Depth 360'	Depth to Static Water Level 70'
TYPE OF COMPLETION: (Circle One or More): <input checked="" type="checkbox"/> Gravel Packed, <input type="checkbox"/> Underreamed, <input type="checkbox"/> Telescoped, <input checked="" type="checkbox"/> Natural Development, <input type="checkbox"/> Open Hole, <input type="checkbox"/> Other (Describe) _____		
Top of Lap Pipe or Reduction in Casing		
FEET <input type="checkbox"/> IF TELESCOPED OR MORE THAN ONE SCREEN: USE BACK PAGE		

LOG DATA	
TYPE OF LOG RUN (Circle One): Electric, Gamma Ray, Density, Sonic, Neutron, Other (Describe) _____ <input checked="" type="radio"/> No Log Run	
Name of Organization Running Log	

SCREEN DATA		
Diameter - Inches 2	Length - Feet 10	Slot Size - Inches .0006
Screen Type pvc	Depth to Bottom - Feet 360	

GEOLOGIC DATA (Office Use Only)			
Surface Elev.	Geologic Unit	Unit Thickness	Depth to Top
Subs. SWL	Date	Analysis	Aquifer Test

Driller's Remarks


DESCRIPTION OF FORMATIONS ENCOUNTERED	FROM	TO	FORMER NUMBER	TO
MUD	0	60		
MUD SAND MUD	60	100		
MUD	100	140		
MUD & SAND	140	160		
MUD	160	200		
MUD SAND	200	220		
MUD	220	300		
SAND + MUD	300	320		
MUD + SAND	320	340		
SAND	340	360		

RECEIVED
SEP 23 1991
Dept. of Environmental Quality
Bureau of Land & Water Resources

IF MORE SPACE IS NEEDED, USE BACK

If well telescopes please sketch and show depths.

PA 0
10-5-81

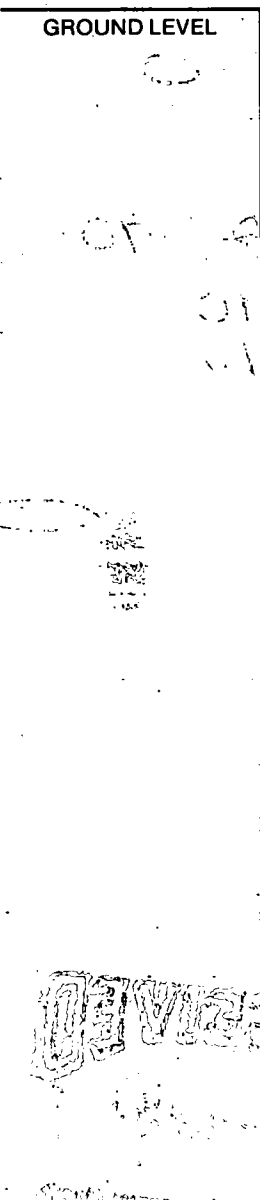

100	100	100	100
75	75	75	75
X			

SECTION _____

Please indicate well location X.

ADDITIONAL INFORMATION

100 100 100

75 75 75

X

100 100 100

75 75 75

100 100 100

75 75 75

DEVIATION

Small information to show
penetration of the screen

If more than one screen,
show location of each on sketch.