

MISSISSIPPI DEPARTMENT OF ENVIRONMENTAL QUALITY
Bureau of Land and Water Resources

P. O. Box 10631
Jackson, MS 39289-0631
WATER WELL DRILLERS LOG

COUNTY WELL LOCATED Harrison
WELL NUMBER CODED F 2137
DATE WELL COMPLETED 2/11/91

PERMIT NUMBER 0539*
NAME OF DRILLING FIRM McMill Pump & Well

NAME & MAILING ADDRESS OF LANDOWNER Arson Fortune			
15580 C C Camp Rd			
Lot. No. 39503			
WELL LOCATION: SEC	TOWNSHIP	RANGE	
21	6	N 12	W
DISTANCE	DIRECTION	NEAREST TOWN	
3 Miles	East	Byance	
OTHER LANDMARK			
WELL PURPOSE <input checked="" type="radio"/> Home, Irrigation, Municipal, Industrial, Fish Pond, etc.			

PUMP DATA		
PUMP TYPE (Circle One): Submersible, Turbine, <input checked="" type="radio"/> Jet, Flowing Well, Other (Describe) _____		
POWER TYPE (Circle One): <input checked="" type="radio"/> Electric, Tractor, Diesel, Gasoline, Butane, Other (Describe) _____ H/P _____		
Pump Capacity (GPM)	No. of Stages	Setting Depth
12	2	70' FT.
PUMP TEST		
Well yielded 12 GPM with a drawdown of 10 ft. after 1 hours of pumping		

WELL DATA		
Well Depth 190'	Casing Diameter (In.) 2"	Casing Length (Ft.) 8180'
Type of Casing PVC	Hole Depth 190'	Depth to Static Water Level 50'
TYPE OF COMPLETION: (Circle One or More): <input checked="" type="radio"/> Gravel Packed, <input type="radio"/> Underreamed, <input type="radio"/> Telescoped, <input checked="" type="radio"/> Natural Development, <input type="radio"/> Open Hole, <input type="radio"/> Other (Describe) _____		
Top of Lap Pipe or Reduction in Casing		
FEET IF TELESCOPED OR MORE THAN ONE SCREEN: USE BACK PAGE		

LOG DATA	
TYPE OF LOG RUN (Circle One): Electric, Gamma Ray, Density, Sonic, Neutron, Other (Describe) _____ <input checked="" type="radio"/> No Log Run	
Name of Organization Running Log	

SCREEN DATA		
Diameter - Inches 2"	Length - Feet 10'	Slot Size - Inches .0006
Screen Type PVC	Depth to Bottom - Feet 190'	

GEOLOGIC DATA (Office Use Only)			
Surface Elev.	Geologic Unit	Unit Thickness	Depth to Top
Subs. SWL	Date	Analysis	Aquifer Test


Driller's Remarks

DESCRIPTION OF FORMATIONS ENCOUNTERED	FROM	TO
Sand	0	40
mud	40	90
Sand	90	110
mud	110	170
Sand	170	190

FORMATIONS (Continued)	FROM	TO
RECEIVED		
DEC 02 1991		
Dept. of Environmental Quality Bureau of Land & Water Resources		
IF MORE SPACE IS NEEDED, USE BACK		

If well telescopes please sketch and show depths.

GROUND LEVEL

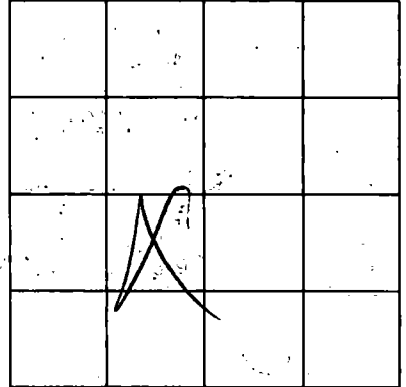

SECTION _____

Please indicate well location X.

ADDITIONAL INFORMATION

RECEIVED

1973 0 0 10

UNITED STATES DEPARTMENT OF THE INTERIOR
BUREAU OF LAND MANAGEMENT

If more than one screen,
show location of each on sketch.