

HAR.

MISSISSIPPI BOARD OF WATER COMMISSIONERS

F 2161
10-12-65

U 361512

WATER WELL DRILLERS LOG

Date: 10-12-65, 19___, Driller: C. T. Surtzwell Co County Harrison
(Name)

(1) Owner of Land: Tom E Wheeler
(Name)

John Clark Road Spurt
(Address)

(2) Location: 1/4, 1/4, Sec 6, 12
Nugent
miles (distance), (direction) of (Nearest Town)

(3) Topography: X
(Hilly) (Flat) (Level)

(4) Purpose of Well: domestic
(Domestic Irrigation
Municipal, Industrial, Other)

Description & Color of Materials Sand, Clay, Red Clay, Shell, etc.	Thick- ness Feet	Depth Feet
Clay	0	20
Clay + sand silt	20	40
Clay	40	80
Sand	80	90
Clay	90	140
Clay + sand silt	140	160
Clay	160	180
Sand	180	220

Information upon completion of well:

(1) Diameter 3 x 2 inches.

(2) Total Depth 220 feet.

(3) Water Level 53' 6" feet below top of ground.

(4) Cased to 220, Size 3" x 2"


(5) Screen: Size 10 mesh, Length 10'

(6) Were any formations sealed against pollution?
X yes, ___ no.

If YES depth of formation _____

Why Health Dept Repts

Drillers Remarks: _____

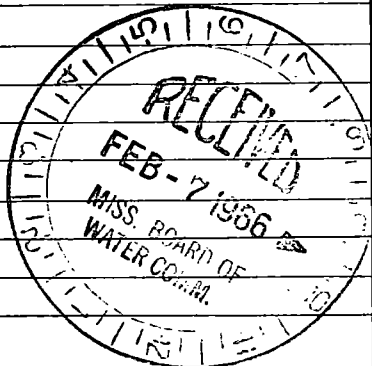

(Use Back Side)

Well No.

