

MISSISSIPPI DEPARTMENT OF ENVIRONMENTAL QUALITY

Office of Land and Water Resources

P. O. Box 10631
Jackson, MS 39289-0631

WATER WELL DRILLERS LOG

COUNTY WELL LOCATED Harrison	
WELL NUMBER F-2206	CODED
DATE WELL COMPLETED 5/15/00	

PERMIT NUMBER 0404
NAME OF DRILLING FIRM Lyman Well Co.
Reelfoot Ms 39503

NAME & MAILING ADDRESS OF LANDOWNER Lou Wallace			
John Clark Road			
Reelfoot Ms 39503			
WELL LOCATION	SEC	TOWNSHIP	RANGE
	26	6 S	12 E
DISTANCE	DIRECTION	NEAREST TOWN	
OTHER LANDMARK			
WELL PURPOSE <input checked="" type="checkbox"/> Home <input type="checkbox"/> Irrigation, Municipal, Industrial, Fish Pond, etc.			

PUMP DATA		
PUMP TYPE (Circle One): <input checked="" type="checkbox"/> Submersible, <input type="checkbox"/> Turbine, <input type="checkbox"/> Jet, <input type="checkbox"/> Flowing Well, Other (Describe) _____		
POWER TYPE (Circle One): <input checked="" type="checkbox"/> Electric, <input type="checkbox"/> Tractor, <input type="checkbox"/> Diesel, <input type="checkbox"/> Gasoline, <input type="checkbox"/> Butane, Other (Describe) _____ H/P 1/2		
Pump Capacity (GPM) 27	No. of Stages 10	Setting Depth 140 FT.
PUMP TEST		
Well yielded _____ GPM with a drawdown of _____ ft. after _____ hours of pumping		

WELL DATA		
Well Depth 520	Casing Diameter (In.) 4x2	Casing Length (Ft.) 520
Type of Casing PVC	Hole Depth 525	Depth to Static Water Level 110'

TYPE OF COMPLETION: (Circle One or More):
 Gravel Packed, Underreamed, Telescoped,
 Natural Development, Open Hole, Other

WELL GROUTED TO A DEPTH OF **25** FEET
 Type Grout (circle one): Cement, Bentonite or Mix

SCREEN DATA		
Diameter - Inches 2	Length - Feet 30'	Slot Size - Inches .008
Screen Type PVC Saw	Depth to Bottom - Feet 520'	

LOG DATA	
TYPE OF LOG RUN (Circle One): <input type="checkbox"/> Electric, <input type="checkbox"/> Gamma Ray, <input type="checkbox"/> Density, <input type="checkbox"/> Sonic, <input checked="" type="checkbox"/> Neutron, Other (Describe) _____	
Name of Organization Running Log	

GEOLOGIC DATA (Office Use Only)			
Surface Elev.	Geologic Unit	Unit Thickness	Depth to Top
Subs. SWL	Date	Analysis	Aquifer Test


Driller's Remarks	
Top of Lap Pipe or Reduction in Casing 240 FEET	
IF TELESCOPED OR MORE THAN ONE SCREEN: USE BACK PAGE	

DESCRIPTION OF FORMATIONS ENCOUNTERED	FROM	TO
brown, white, red clay	0	110
blue clay	110	300'
blue sand	300	330
blue clay	330	460
blue & gray sand	460	520

FORMATIONS (Continued)	FROM	TO
RECEIVED		
JUN 29 2000		
Dept. of Environmental Quality Office of Land & Water Resources		
IF MORE SPACE IS NEEDED, USE BACK		

If well telescopes please sketch and show depths.

GROUND LEVEL

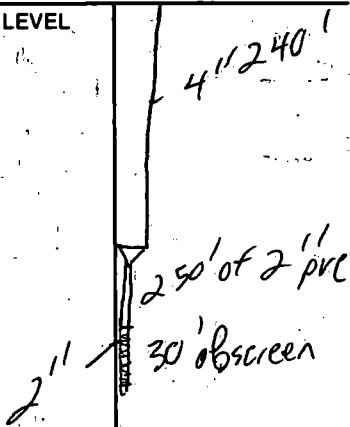

SECTION _____

Please indicate well location X.

ADDITIONAL INFORMATION

RECEIVED

If more than one screen,
show location of each on sketch.