

HAR.

MISSISSIPPI BOARD OF WATER COMMISSIONERS

F 18

10-25-60

WATER WELL DRILLERS LOG

?


Date: Oct 25, 1960, Driller: Joe Miller County Harrison

- (1) Owner of Land: St Ana Catholic Church RR# Sheffield Miss (Name) (Address)
(2) Location: 1/4, 1/4, Sec. T R 8 miles North West of Lyman (distance) (direction) (Nearest Town)
(3) Topography: Hilly (Hilly) (Flat) (Level)
(4) Purpose of Well: Domestic (Domestic Irrigation Municipal, Industrial, Other)

Table with 3 columns: Description & Color of Materials Sand, Clay, Red Clay, Shell, etc.; Thickness Feet; Depth Feet. Rows include Surface, Red + Wh Cl., Wh Clay, Brown Cl., Wh Cl., Blue Cl., Blue Cl., Small Sand Beach, Wh Cl., Blue Sand (Fine), Hard Blue Cl., Blue Gray Sand, Fine, and Hard Blue Cl.

Information upon completion of well:

- (1) Diameter 2 inches.
(2) Total Depth 310 feet.
(3) Water Level 64 feet below top of ground.
(4) Cased to 298, Size 2
(5) Screen: Size 2, Length 10
(6) Were any formations sealed against pollution? yes, no.

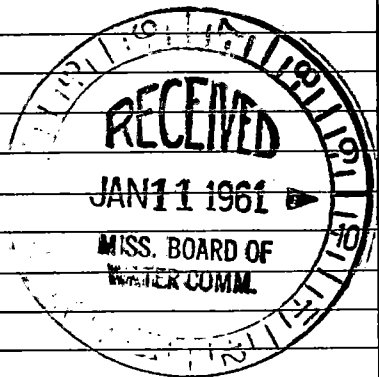

If YES depth of formation
Why
Drillers Remarks:

(Use Back Side)

Well No.

Y

1/2000
1/2000

