

HAR.

9

F 20

8-17-61

WATER WELL DRILLERS LOG

Date: 8-17, 1961, Driller: C. T. SWITZER WELL CO. County: Harrison


(Name)

(1) Owner of Land:	Description & Color of Materials Sand, Clay, Red Clay, Shell, etc.	Thick- ness Feet	Depth Feet
Lloyd Murphy (Name) Star Rt, Gautier (Address)	clay	0	10
	sand	10	20
	clay	20	41
(2) Location: _____ 1/4, _____ 1/4, Sec. _____ T. R. _____	sand	41	51
_____ miles _____ of _____ (distance) (direction) (Nearest Town)	clay	51	94
(3) Topography: _____ (Hilly) (Flat) (Level)	good sand	94	146
(4) Purpose of Well: Domestic (Domestic Irrigation Municipal, Industrial, Other)	clay	146	206
	good sand	206	284

Information upon completion of well:

- (1) Diameter 2" inches.
- (2) Total Depth 284' feet.
- (3) Water Level 10' feet below top of ground.
- (4) Cased to 284', Size 2"
- (5) Screen: Size 2", Length 10'
- (6) Were any formations sealed against pollution?
X yes, _____ no.

If YES depth of formation _____
 Why Health Dept Requirement
 Drillers Remarks: _____

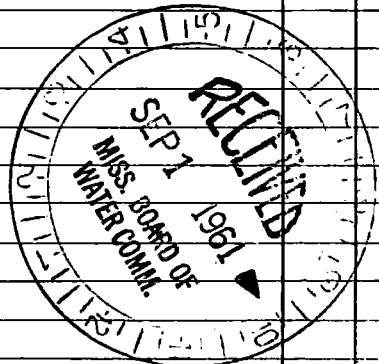

(Use Back Side)

Well No.

WATER WELL DRILLING REPORT

DATE: 11/11/50

	(7) Owner of land Class
	Address
	(3) Location to N. Sec. 1, T. 10 N., R. 10 E., S. 10
	Miles (Latitude) (Longitude)
	(2) Topography (High) (Low)
	(4) Purpose of Well (Irrigation) (Municipal) (Industrial) (Domestic)
	Information upon completion of well
	(1) Diameter Inches
	(2) Total Depth Feet
	(3) Water level Feet below top of ground
	(4) Cased to Size
	(5) Screen size Length
	(6) Were any formations sealed against pollution?
	If YES depth of formation
	Why
	Driller's Remarks