

Harrison
G
2-13-75

MISSISSIPPI
BOARD OF WATER COMMISSIONERS
416 North State Street
Jackson, Mississippi 39201

WATER WELL DRILLERS LOG

CODED

Feb 13 1975 McGill well works Harrison
date well completed firm name county well located

LANDOWNER: Kenny Coch
Huggart, Miss

description of formations encountered	from	to
clay	0	21
sand	2	42
sand	42	63
sand	63	84
clay	84	105
clay	105	126
clay	126	147
clay	147	236
sand	236	336
mud	336	357
sand	357	378
course sand	378	399
	399	419

(mailing address)


WELL LOCATION:
sec. 18 T. 6 N. R. 11 E. ¹³⁵
3 miles NW of Lynn
(distance) (direction) (nearest town)

WELL PURPOSE: home
(home, irrigation, municipal, industrial)

- WELL COMPLETION DATA:
- (1) diameter (inches) 2"
 - (2) total depth (feet) 419'
 - (3) static water level (feet) 55' ^{below} above top of ground.
 - (4) casing alaste 409'
(material) (depth)
2"
(size) if telescope see back.
 - (5) screen 10' 5.5'
(length) (depth to top)
2" 5.5'
(size) (material)
 - (6) pump 1 10
(HP) (yield gpm)
Electric
(type power)
 - (7) electric log no
(yes or no)
- (organization running log)

(8) how well bottom plugged back
wash valve


DRILLERS REMARKS:

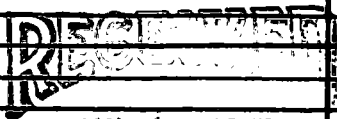

MAR 14 1975

If well telescopes please sketch and show depths.

GROUND LEVEL

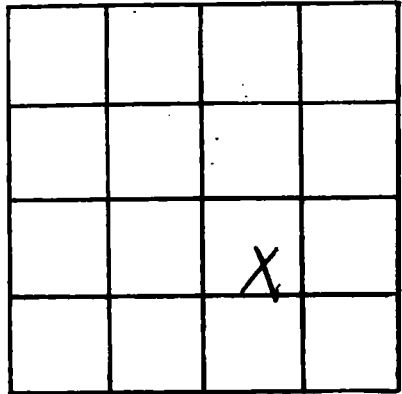

SECTION 18

Please indicate well location X.

ADDITIONAL INFORMATION

A series of horizontal lines for writing additional information.

If more than one screen, show locations of each on sketch.