

HAR.

G2

4-26-63

MISSISSIPPI BOARD OF WATER COMMISSIONERS
WATER WELL DRILLERS

CODED

Harrison

Date: April 26, 1963, Driller: Robert E. Rathbun County: Stoddard
(Name)

(1) Owner of Land: Lynan National Fish Hatchery
(Name)
Lynan, Miss
(Address)

(2) Location: SE 1/4, SW 1/4, Sec. 17 T6R11
(distance) (direction) (Nearest Town)

(3) Topography: _____
(Hilly) (Flat) (Level)

(4) Purpose of Well: To fish Hatchery
(Domestic, Irrigation, Municipal, Industrial, Other)

| Description & Color of Materials Soil, Clay, Sand, Gravel, etc. | Thick- ness Feet | Depth Feet |
|--|------------------------|---------------|
| <u>0-20 top soil</u> | | |
| <u>20-221 mud sand mixture</u> | | |
| <u>221-323 Blue shale</u> | | |
| <u>323-471 sand</u> | | |
| <u>471-483 Blue shale</u> | | |

Information upon completion of well:

(1) Diameter 6 inches.

(2) Total Depth 483 feet.

(3) Water Level 33 feet below top of ground.

(4) Cased to 435, Size _____

(5) Screen: Size 4", Length 20'


(6) Were any formations sealed against pollution?
 yes, _____ no.

If YES depth of formation 435

Why _____

Drillers Remarks: _____

CODED

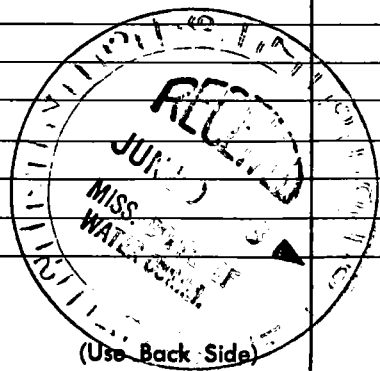

(Use Back Side)

Well No.

