

HAR.

MISSISSIPPI BOARD OF WATER COMMISSIONERS

CODED
J-306

G 11

u 393501

8-24-60

WATER WELL DRILLERS LOG

Date: 8-24, 1960, Driller: Sutter Well Wks. County Harrison

(Name)

(1) Owner of Land: LYMAN School

(Name)

Lyman, Miss.

(Address)

(2) Location: 1/4, 1/4, Sec 29 T 6 R 11

_____ miles
(distance)

(direction)

1/4 of Lyman
(Nearest Town)

(3) Topography: Hilly

(Hilly)

(Flat)

(Level)

(4) Purpose of Well: SCHOOL

(Domestic Irrigation
Municipal, Industrial, Other)

Description & Color of Materials
Sand, Clay, Red Clay, Shell, etc.

Thick-
ness
Feet

Depth
Feet

RED CLAY

64

64

BLUE CLAY

382

446

SAND

58

504

Information upon completion of well:

(1) Diameter 3 x 4 inches.

(2) Total Depth 504 feet.

(3) Water Level 44 feet below top of ground.

(4) Cased ~~so~~ all Top 105' - 4", Size BAL-3"

(5) Screen: Size 3", Length 20'

(6) Were any formations sealed against pollution?

_____ yes, no.


If YES depth of formation _____

Why _____

Drillers Remarks: top 10' cemented;

also 8 x 20 slab around well.

CODED

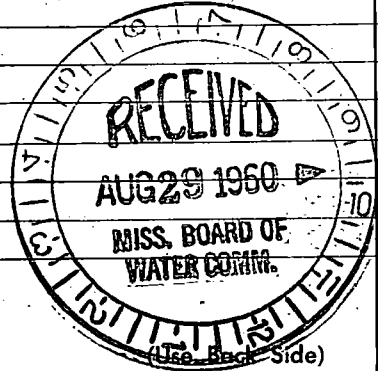

Well No.

100



100

100