

HAR.

CODED
D - 304

G 13

6172755

9-23-60 WATER WELL DRILLERS LOG

Date: Sept. 23, 1960, Driller: A & B Drilling Co. County Harrison
(Name)

(1) Owner of Land: Walter Page
(Name)

(Address)

(2) Location: 1/4, 1/4, Sec. 35 T6 R11 W
_____ miles _____ of _____
(distance) (direction) (Nearest Town)

(3) Topography: Hilly
(Hilly) (Flat) (Level)

(4) Purpose of Well: Domestic
(Domestic Irrigation, Municipal, Industrial, Other)

Description & Color of Materials Sand, Clay, Red Clay, Shell, etc.	Thick- ness Feet	Depth Feet
Red Clay	50	50
White Clay	20	70
Sand	10	80
Blue Clay	10	90
Sand	30	120
Sand & Clay Breaks	6	126
Blue Clay	100	236
Sand & Clay Breaks	13	249
Sand, Coarse	8	257
Blue Clay	4	261
Coarse Sand	14	275
Blue Clay 279-284 on		

Information upon completion of well:

(1) Diameter 2 inches.

(2) Total Depth 272 feet.

(3) Water Level 35 feet below top of ground.

(4) Cased to 262, Size 2"
8 slot

(5) Screen: Size 1/8", Length 10 FT.


(6) Were any formations sealed against pollution?
_____ yes, _____ no.

CODED

If YES depth of formation _____

Why _____

Drillers Remarks: _____

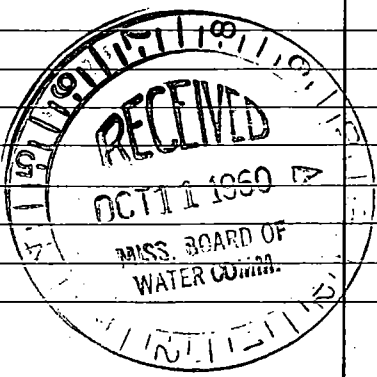

(Use Back Side)

Well No.

