

HAR.

MISSISSIPPI BOARD OF WATER COMMISSIONERS

G 15

9-25-60

WATER WELL DRILLERS LOG

2-305

Date: Sept. 25, 1960, Driller: Joe Miller County Harrison (Name)

(1) Owner of Land: Tom Blue
(Name)
Rt 4 Sulfport
(Address)

(2) Location: 1/4, 1/4, Sec. T. R.
7 miles North of Sulfport
(distance) (Direction) (Nearest Town)

(3) Topography: Flat
(Hilly) (Flat) (Level)

(4) Purpose of Well: Home
(Domestic Irrigation, Municipal, Industrial, Other)

Description & Color of Materials Sand, Clay, Red Clay, Shell, etc.	Thick- ness Feet	Depth Feet
Surface		5
White Sand	19	24
Wh + Red Sand	7	31
Blue Clay	59	90
Break	2	92
Fine Gray Sand	10	102
Hard Blue Clay	250	352
Break	4	356
Fine sand (Mucked)	29	380
Hard Clay	18	398
Fine sand (fine sub)	10	408
Gray Sand (Fair)	11	419
" " (Good)	9	428
Hard Blue Clay	2	430

Information upon completion of well:

(1) Diameter 2" inches.

(2) Total Depth 430' feet.

(3) Water Level 16' feet below top of ground.

(4) Cased to 418', Size 2"


(5) Screen: Size 2", Length 10'

(6) Were any formations sealed against pollution?
 yes, no.

If YES depth of formation

Why

Drillers Remarks:

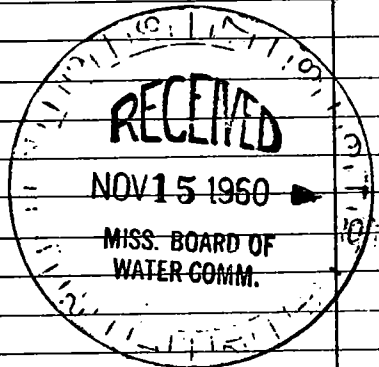

(Use Back Side)

Well No.

