

HAR.

K 394808

G 16

WATER WELL DRILLERS LOG

CODED

301

10 1960

Date: Oct. 60, 1960, Driller: Joe Miller County Harrison
(Name)

- (1) Owner of Land: Joe Davies
(Name)
RRA Shuffout, Miss
(Address)
- (2) Location: 1/4, 1/4, Sec. 33 T 6 R 11
8 miles North, of Shuffout
(distance) (direction) (Nearest town)
- (3) Topography: Flat
(Hilly) (Flat) (Level)
- (4) Purpose of Well: Home
(Domestic Irrigation
Municipal, Industrial, Other)

Description & Color of Materials Sand, Clay, Red Clay, Shell, etc.	Thick- ness Feet	Depth Feet
Surface		10
Red Sand	12	22
White Clay (med)	76	98
Blue Clay	160	258
Sand Break	4	262
Blue Clay	28	290
Sand Break	5	295
Blue Clay (Hard)	28	333
Fine Gray Sand N.G.	32	365
Blue Clay (Hard)	71	436
(Fine) Gray Sand	36	472
Thin "	50	522
Hard "	10	532
Red Sand "	12	544

Information upon completion of well:


- (1) Diameter 2" inches.
- (2) Total Depth 547 feet.
- (3) Water Level 22' feet below top of ground.
- (4) Cased to 537, Size 2"
- (5) Screen: Size 2", Length 10'
- (6) Were any formations sealed against pollution?
_____ yes, _____ no.

If YES depth of formation _____

Why _____

Drillers Remarks: _____

CODED

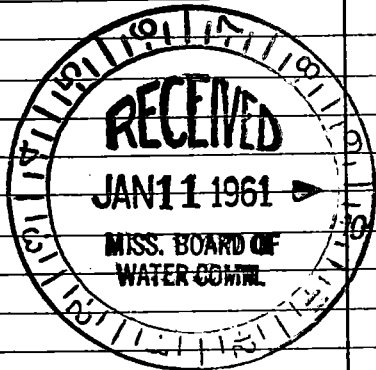


(Use Back Side)

Well No.

Grid
USDA
100
100

N

W

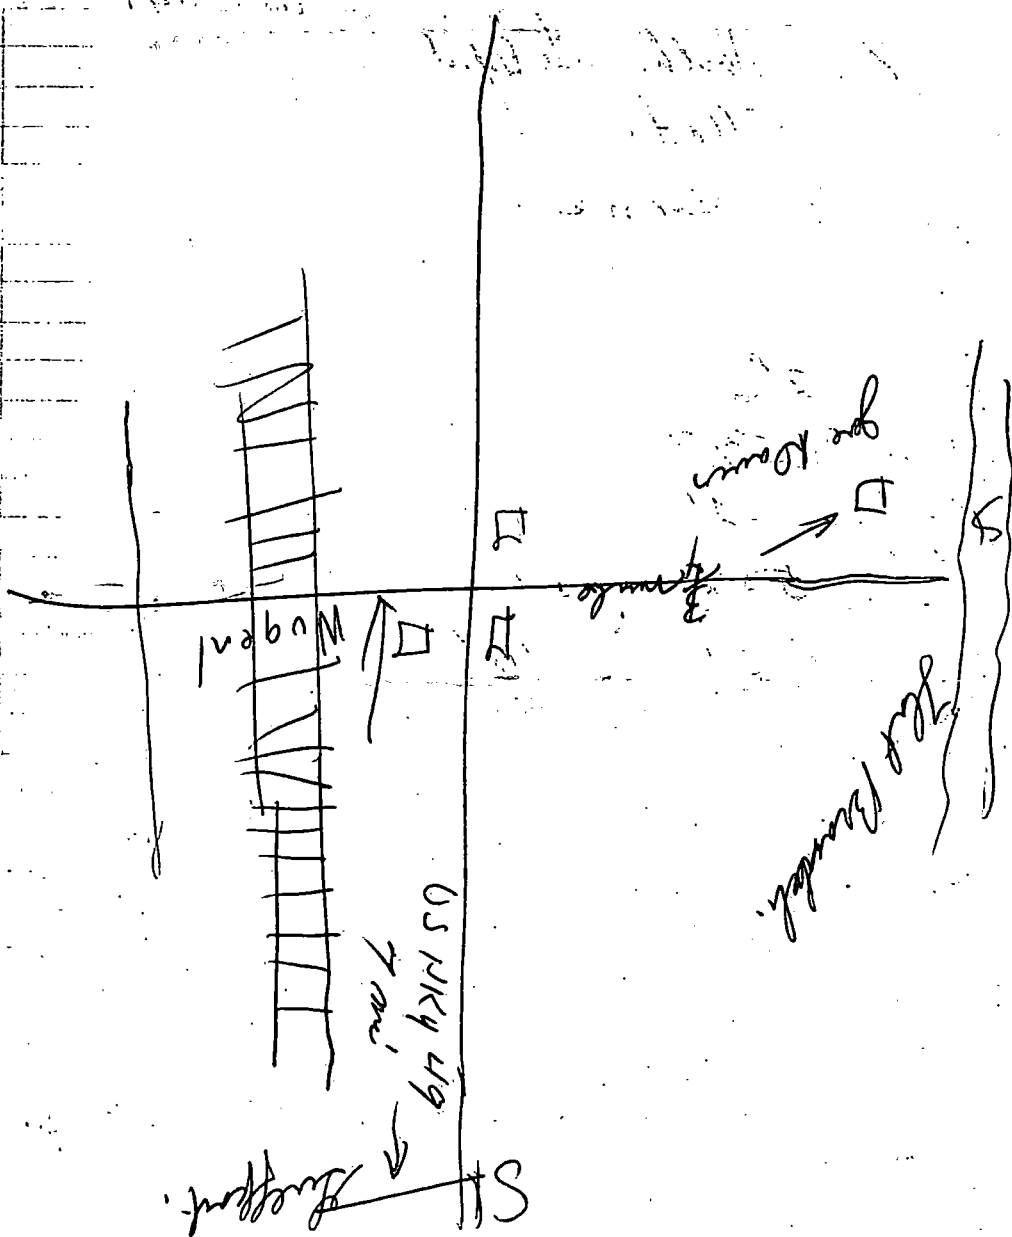

Wagon

US NKY 49

go down

St. Charles

St. Charles

St. Charles

S