

G 21

WATER WELL DRILLERS LOG

G-301

11-10-60

Date: 11-10, 1960, Driller: H'brq Butane County Harrison
(Name)

(1) Owner of Land: <u>Mable White</u> <small>(Name)</small>	Description & Color of Materials Sand, Clay, Red Clay, Shell, etc.	Thick- ness Feet	Depth Feet
<u>Lyman Miss</u> <small>(Address)</small>	<u>white clay</u>	<u>0-20</u>	<u>0-20</u>
(2) Location: <u>1/4</u> , <u>1/4</u> , Sec. <u>T</u> <u>R</u>	<u>yellow "</u>	<u>20-35</u>	<u>20-35</u>
<u>Lyman, Miss</u> <u>miles</u> of <u></u> <small>(distance) (direction) (Nearest Town)</small>	<u>blue "</u>	<u>35-80</u>	<u>35-80</u>
(3) Topography: <u>X</u> <small>(Hilly) (Flat) (Level)</small>	<u>" sand</u>	<u>80-100</u>	<u>80-100</u>
(4) Purpose of Well: <u>domestic</u> <small>(Domestic Irrigation Municipal, Industrial, Other)</small>			


Information upon completion of well:

- (1) Diameter 2 inches.
- (2) Total Depth 100 feet.
- (3) Water level 210 feet below top of ground.
- (4) Cased to _____, Size _____
- (5) Screen: Size 2", Length 5'
- (6) Were any formations sealed against pollution?
 _____ yes, X no.

If YES depth of formation: _____

Why _____

Drillers Remarks: _____

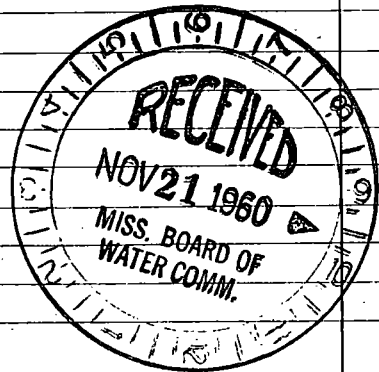

(Use Back Side)

Well No.

