

HAR.

MISSISSIPPI BOARD OF WATER COMMISSIONERS

U 393807
G 177607

CODED

G216
4-2-62

WATER WELL DRILLERS LOG

Date: Apr 2, 1962, Driller: Joe Miller County: Farrison
(Name)

(1) Owner of Land:	Description & Color of Materials Sand, Clay, Red Clay, Shell, etc.	Thick- ness Feet	Depth Feet
<u>Town of Horton</u> (Name)	<u>Surface</u>	<u>10</u>	<u>10</u>
<u>RR # 2 Sulfurt</u> (Address)	<u>White Sand</u>	<u>14</u>	<u>26</u>
<u>Box 309 IN</u> (Address)	<u>Red Clay</u>	<u>54</u>	<u>80</u>
(2) Location: <u>1/4, 1/4, Sec. 31 T6 R11</u>	<u>White Clay</u>	<u>80</u>	<u>160</u>
<u>7</u> miles <u>N.W.</u> of <u>Sulfurt</u> (distance) (direction) (Near Town)	<u>Brown Red Mud (fine)</u>	<u>98</u>	<u>258</u>
(3) Topography: <u>Flat</u> (Hilly) (Flat) (Level)	<u>Blue Clay</u>	<u>211</u>	<u>469</u>
(4) Purpose of Well: <u>Domestic</u> (Domestic Irrigation Municipal, Industrial, Other)	<u>(Fine) Red Sand</u>	<u>46</u>	<u>515</u>
	<u>Sea Sand (Grass)</u>	<u>31</u>	<u>546</u>
	<u>Sand - Fine</u>	<u>11</u>	<u>557</u>
	<u>Blue Clay</u>	<u>7</u>	<u>564</u>

Information upon completion of well:


- (1) Diameter 2" inches.
- (2) Total Depth 564' feet.
- (3) Water Level 49' feet below top of ground.
- (4) Cased to 536, Size 2"
- (5) Screen: Size 2", Length 10'
- (6) Were any formations sealed against pollution?
yes, no.

If YES depth of formation 12'
Why VA. Land. to Meet
Drillers Remarks: Health Standard

over

used 18' Jackleg
Pumping 1800 GPH
By Air Pumping

CODED

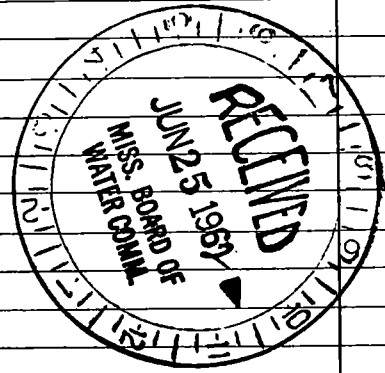


(Use Back Side)

Well No.

6-11-49

US ARMY 49

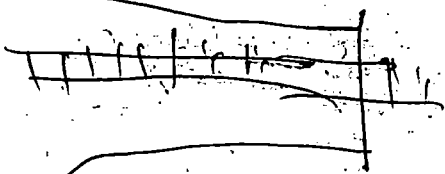

[Faint, illegible handwritten notes]

John Clark
Land

Well
↙

Canal Rd

