

Harrison
 G 22625
 4-15-74

MISSISSIPPI
 BOARD OF WATER COMMISSIONERS
 416 North State Street
 Jackson, Mississippi 39201

CODED

CODED

WATER WELL DRILLERS LOG

4/15 1974 COASTAL DRILLING & SERVICE CO. Harrison
 date well completed ROUTE 1 BOX 678 county well located

LANDOWNER: Mr. D. C. BLOOM, MISS.
 Rt 3 Box 263 B
 Apt 201
 (mailing address)

description of formations encountered	from	to
Top Soil	3	3
Red Shales	3	15
White Sand	15	36
Sand	36	40
Shells	40	42
Blue Shales	42	100
White Sand	100	200
Good Blue Clay	200	410
Iron water sand	410	440
Iron water sand	440	463


WELL LOCATION:
 sec 31 T 6 N R 11 E 135
 S W
 (3) Miles N.W. Jordan
 (distance) (direction) (nearest town)

WELL PURPOSE: Home
 (home, irrigation, municipal, industrial)

WELL COMPLETION DATA:

- (1) diameter (inches) 2"
- (2) total depth (feet) 463'
- (3) static water level (feet) 4' below top of ground.
- (4) casing POC, 453'
 (material) (depth)
 (size) If telescope see back.
- (5) screen 10', 453'
 (length) (depth to top)
 2" POC
 (size) (material)
- (6) pump 5hp
 (HP) (yield gpm)
 5hp
 (type power)
- (7) electric log no
 (yes or no)

CODED

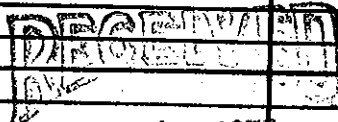

JUL 17 1975

DRILLERS REMARKS: