

HAR.
G 34
5-15-62

WATER WELL DRILLERS **CODED**

Date: May 15, 1962, Driller: Joe Miller County Harrison

BARNEY KIRK PATRICK

- (1) Owner of Land: Barney Kirkpatrick
(Name)
RR# 1 - Box Suffer Miss
(Address)
- (2) Location: 1/4, C&A 1/4, Sec. 7 T28R11W
11 miles North of Suffer,
(distance) (direction) (Nearest Town)
- (3) Topography: Hilly
(Hilly) (Flat) (Level)
- (4) Purpose of Well: Domestic
(Domestic Irrigation
Municipal, Industrial, Other)


Description & Color of Materials Sand, Clay, Red Clay, Shell, etc.	Thick- ness Feet	Depth Feet
<u>Surface Clays</u>	<u>18</u>	<u>18</u>
<u>Brown Sand</u>	<u>52</u>	<u>70</u>
<u>Blue Clay</u>	<u>250</u>	<u>320</u>
<u>Two hard Buckey Clay</u>	<u>68</u>	<u>388</u>
<u>Sand. Good</u>	<u>2</u>	<u>390</u>
<u>Gr. Sand. Good</u>	<u>10</u>	<u>400</u>
<u>Little Finer. Sand</u>	<u>10</u>	<u>410</u>
<u>Sand. Very Good</u>	<u>10</u>	<u>420</u>
<u>" " " "</u>	<u>9</u>	<u>430</u>
<u>" " " "</u>	<u>2</u>	<u>440</u>
<u>Blue Clay, (Hd)</u>	<u>2</u>	<u>442</u>

Information upon completion of well:

- (1) Diameter 2 inches.
- (2) Total Depth 442 feet.
- (3) Water Level 19 1/2 feet below top of ground.
- (4) Cased to 432, Size 2"
- (5) Screen: Size 2", Length 10'
- (6) Were any formations sealed against pollution?
_____ yes, _____ no.

Pumping 1800 GPH
by #11 Pumping

CODED

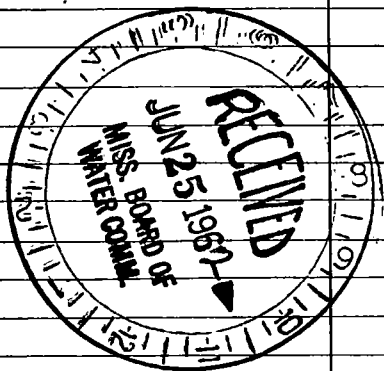

If YES depth of formation _____

Why _____


Drillers Remarks: _____

(Use Back Side)

Well No.

0200

Little Binox River

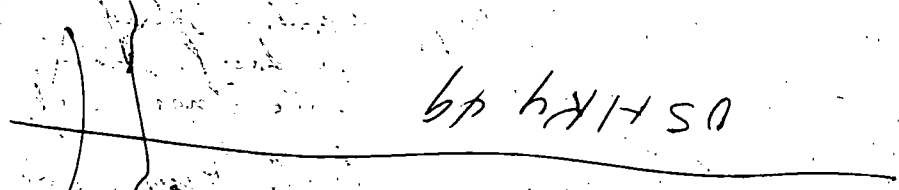

OSHKY 49



well