

HAR.
G37
6-19-62

WATER WELL DRILLERS LOG

CODED

Date: June 19, 1962, Driller: Joe Miller County Marion
(Name)

(1) Owner of Land:	Description & Color of Materials Sand, Clay, Red Clay, Shell, etc.	Thick- ness Feet	Depth Feet
<u>Harry Meisner</u> (Name) <u>RR# Suffolk Miss.</u> (Address)	<u>Red & Brown Clay</u>	45	45
(2) Location: <u>SW 1/4, Sec. 20 T. 85 R. 11</u>	<u>Blue Clay</u>	15	60
<u>9</u> miles <u>North</u> of <u>Suffolk</u> (distance) (direction) (Nearest Town)	<u>Fine Brown Sand & Clay</u>	20	80
(3) Topography: <u>Hilly</u> (Hilly) (Flat) (Level)	<u>Blue Clay</u>	130	210
(4) Purpose of Well: <u>Domestic</u> (Domestic Irrigation Municipal, Industrial, Other)	<u>Chert?</u>	12	222
	<u>Blue Clay</u>	168	390
	<u>Sand, Fair</u>	11	401
	<u>Sand, Fair</u>	10	411
	<u>Sand, Good</u>	10	421
	<u>Sand, Good</u>	11	432
	<u>Sand, Fair</u>	10	442

Information upon completion of well:

- (1) Diameter 2" inches.
- (2) Total Depth 442' feet.
- (3) Water Level 38' feet below top of ground.
- (4) Cased to 422', Size 2"
- (5) Screen: Size 2", Length 10'
- (6) Were any formations sealed against pollution?
_____ yes, _____ no.

If YES depth of formation _____
Why _____

Drillers Remarks:


over

CODED

(Use Back Side)

Well No.

Support

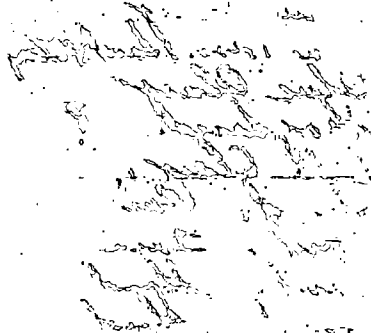

US 49

53.



$\frac{3}{4}$ mi

N