

HAR.
G 38

WATER WELL DRILLERS LOG

G

Date: July 30, 1962, Driller: Joe Miller
7-30-62

CODED City Harrison
(Name)

(1) Owner of Land: Hathis
(Name)
RRH Sufferd Miss
(Address)

(2) Location: NE 1/4, NW 1/4, Sec. 29 T6S R 11W
9 miles North, of Gult part.
(distance) (direction) (Nearest Town)

(3) Topography: Hilly
(Hilly) (Flat) (Level)

(4) Purpose of Well: Domestic
(Domestic Irrigation
Municipal, Industrial, Other)

Description & Color of Materials Sand, Clay, Red Clay, Shell, etc.	Thick- ness Feet	Depth Feet
Surface	10	10
Sand	5	15
White & Pink Clay	55	70
Tan sand	21	91
Red sand	1	92
Iron Wash	1	93
Blue Clay	287	380
Sand (Fine)	20	400
Sand (Fine)	22	422
Blue Clay (Hard)	18	440
Gray sand (Fine)	12	452
Gray sand (Fine)	11	463
Gray sand (Hard)	32	495
Spaly sand (Fine)	10	505
Soft Clay & sand NG	11	516

Information upon completion of well:


- (1) Diameter 2 inches.
- (2) Total Depth 516 feet.
- (3) Water Level 35 feet below top of ground.
- (4) Cased to 485, Size 2"
- (5) Screen: Size 2', Length 10'
- (6) Were any formations sealed against pollution?

_____ yes, _____ no.

If YES depth of formation _____


Why _____

Drillers Remarks: _____

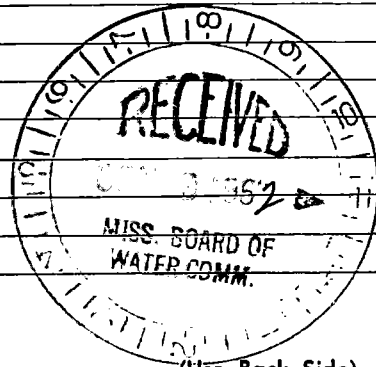

(Use Back Side)

Well No.

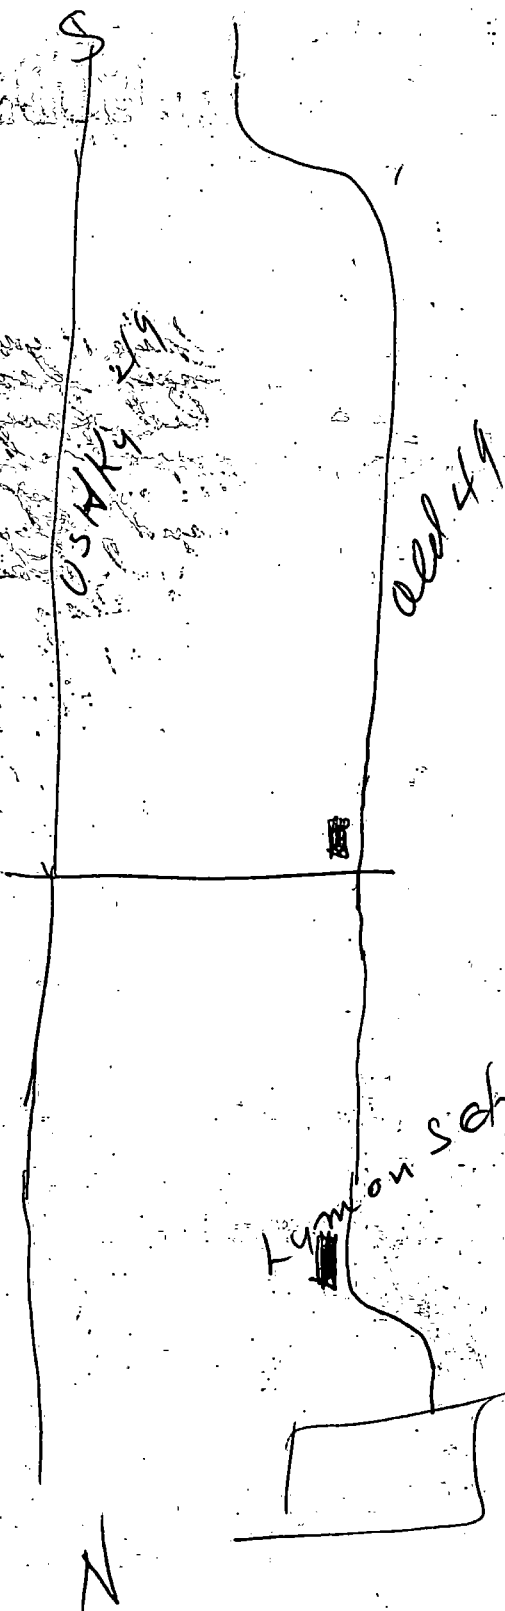

OSAKY 49

Old 49

Lynn School

Lynn

S

N