

HAR.

MISSISSIPPI BOARD OF WATER COMMISSIONERS

G-39 K393102
12-3-65

WATER WELL DRILLERS LOG

CODED

Date: Dec 3, 19 65, Driller: Joe Miller County Harrison
(Name)

(1) Owner of Land: Elton Stewart
(Name)
RR # Gulfport
(Address)

(2) Location: 1/4, 1/4, Sec. 27 T 6 R 11
10 miles N.E. of Gulfport
(distance) (direction) (Nearest Town)

(3) Topography: Hilly
(Hilly) (Flat) (Level)

(4) Purpose of Well: Domestic
(Domestic Irrigation
Municipal, Industrial, Other)

Description & Color of Materials Sand, Clay, Red Clay, Shell, etc.	Thick- ness Feet	Depth Feet
Surface	5	5
Coarse Sand (Red)	11	16
Red Wh Clay Mix	4	20
White Clay	19	39
Blue Clay	75	114
Sand, Tan, Not Mod	15	129
Hard Blue Clay	81	210
Clay + Sm Br.	11	231
Hard Blue Clay	148	379
Sand, Fine, Blk	14	393
Hard Blue Clay	13	408
" " "	6	414
Sand, Fine (Gray)	61	475
" Fair "	21	496
" Good "	16	512
Hard Blue Clay	4	516
5' Tail Pipe		

Information upon completion of well:

(1) Diameter 2" inches.

(2) Total Depth 516' feet.

(3) Water Level 30' feet below top of ground.

(4) Cased to 502, Size 2"


(5) Screen: Size 2", Length 10'

(6) Were any formations sealed against pollution?
_____ yes, _____ no.

If YES depth of formation _____

Why _____

Drillers Remarks: _____

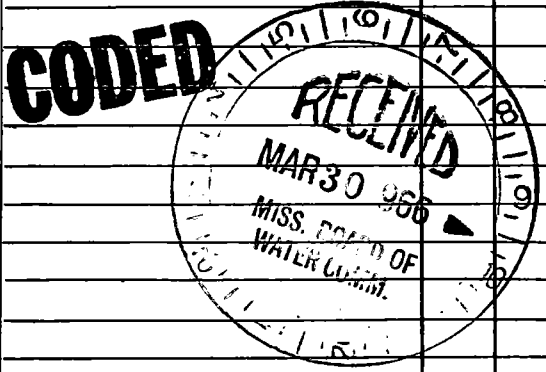

(Use Back Side)

Well No.

0000

11/10