

HAR.

MISSISSIPPI BOARD OF WATER COMMISSIONERS

G-41
9-20-62

WATER WELL DRILLERS

CODED G

Date: 9-20, 1962, Driller: Sutter Well Works County Harrison

(Name)

(1) Owner of Land: Sylvester Moran
(Name)
Rt. 2 Gulfport, Miss.
(Address)

(2) Location: Sw 1/4, SW 1/4, Sec. 31 T6R11N
2 miles W of August
(distance) (direction) (Nearest Town)

(3) Topography: hilly
(Hilly) (Flat) (Level)

(4) Purpose of Well: domestic
(Domestic Irrigation
Municipal, Industrial, Other)

Description & Color of Materials Sand, Clay, Red Clay, Shell, etc.	Thick- ness Feet	Depth Feet
<u>Clay</u>	<u>18</u>	<u>18</u>
<u>sand</u>	<u>32</u>	<u>50</u>
<u>Clay</u>	<u>40</u>	<u>90</u>
<u>sand</u>	<u>20</u>	<u>110</u>
<u>Clay</u>	<u>58</u>	<u>168</u>
<u>sand</u>	<u>41</u>	<u>209</u>

Information upon completion of well:


- (1) Diameter 2 inches.
- (2) Total Depth 209 feet.
- (3) Water Level 30 feet below top of ground.
- (4) Cased to all, Size 2"
- (5) Screen: Size 2", Length 5'
- (6) Were any formations sealed against pollution?
 yes, no.

If YES depth of formation _____

Why _____

Drillers Remarks: _____

CODED

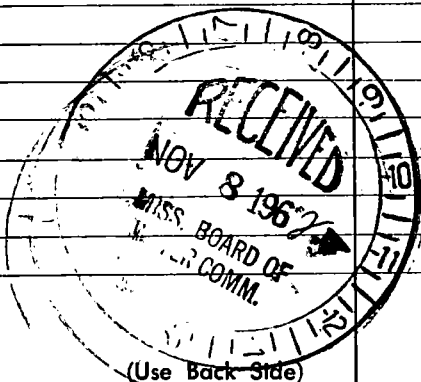

Well No.

1917

Received of Mr. J. H. ...

31
10
11
12
...

...

